

F40

WATER WELL DRILLERS LOG

CODED

8-15-62

Date: 8-15, 1962 Driller: R.R. Nicholas County, Neshoba

PR-49 John Willis (Name)

(1) Owner of Land: U.S. Govt.

Phila. Miss. (Name) 19 11 11 (Address)

(2) Location: 1/4, 1/4, Sec. T R

7 1/2 miles west of Phila. (distance) (direction) (Nearest Town)

(3) Topography: Hilly (Hilly) (Flat) (Level)

(4) Purpose of Well: Domestic (Domestic Irrigation Municipal, Industrial, Other)

Description & Color of Materials Sand, Clay, Red Clay, Shell, etc.	Thick- ness Feet	Depth Feet
Chalk & Clay	1	20
rock	20	26
Shell & blue dirt	26	35
Chalk & Sand	35	43
water sand	43	55

CODED

Information upon completion of well:

(1) Diameter 3 7/8 inches.

(2) Total Depth 55 feet.

(3) Water Level 45 feet below top of ground.

(4) Cased to Joint, Size 2"


(5) Screen: Size 2", Length 5ft.

(6) Were any formations sealed against pollution? yes, no.

If YES depth of formation 10 ft. 4" Pipe

Why: Sanitary Purpose

Drillers Remarks: Cylinder set 48 ft

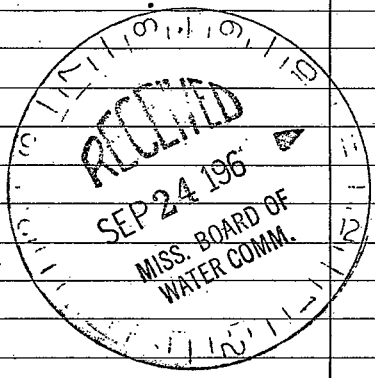

(Use Back Side)

Well No.

Handwritten notes in the top section of the page, including the word "Mammals" and several lines of illegible cursive text.

Handwritten notes in the bottom section of the page, including the word "Mammals" and several lines of illegible cursive text.