

NESHOBA

F42

8+13-62

WATER WELL DRILLERS LOG

CODED

Date: 8-13, 1962 Driller: P. R. Nicholson County Neshoba
PR-51 mable York (Name)

(1) Owner of Land: U.S. Govt.
Phila. Miss.
(Name) (Address) 19 11 11
(2) Location: 1/4, 1/4, Sec. T R
7 miles west of Phila.
(distance) (direction) (Nearest Town)
(3) Topography: Hilly
(Hilly) (Flat) (Level)
(4) Purpose of Well: Domestic
(Domestic Irrigation) (Municipal, Industrial, Other)


Description & Color of Materials Sand, Clay, Red Clay, Shell, etc.	Thick- ness Feet	Depth Feet
Chalk & clay	1	20
Mix Sand & Chalk	20	43
black dirt	43	105
blue dirt & sand	105	132
water sand	120	132

CODED

Information upon completion of well:

(1) Diameter 3 7/8 inches.
(2) Total Depth 132 feet.
(3) Water Level 100 feet below top of ground.
(4) Cased to Point, Size 2"
(5) Screen: Size 2", Length 5'
(6) Were any formations sealed against pollution?
yes, no.

If YES depth of formation 11 ft 4" Pipe
Why Sanitary Purpose
Drillers Remarks: Cylinder set
114 ft

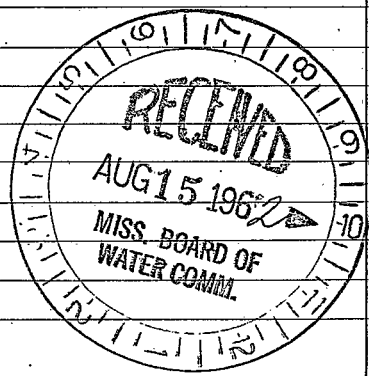

(Use Back Side)

Well No.

1/2

1/2

