

NESHOPA

F46

WATER WELL DRILLERS LOG

CODED

6-5-62

Date: 6-5, 1962, Driller: P.R. Nicholson County Neshoba

PR-59 Thompson Bell (Name)

(1) Owner of Land: VS Court. Phila. Miss. (Name) (Address)

(2) Location: 1/4, 30, 11, 10 T R. 5 1/4 miles West of Phila. (distance) (direction) (Nearest Town)

(3) Topography: Hilly (Hilly) (Flat) (Level)

(4) Purpose of Well: Domestic (Domestic Irrigation Municipal, Industrial, Other)

Description & Color of Materials Sand, Clay, Red Clay, Shell, etc.	Thick- ness Feet	Depth Feet
Clay & Sand	1	63
Rock	63	125
blue dirt	125	135
Coarse Water Sand	135	147


CODED

Information upon completion of well:

- (1) Diameter 4 1/2 inches.
- (2) Total Depth 147 feet.
- (3) Water Level 110 feet below top of ground.
- (4) Cased to Point, Size 2"
- (5) Screen: Size 2", Length 5'
- (6) Were any formations sealed against pollution?
yes, no.

If YES depth of formation
Why

Drillers Remarks: Good well cylinder set at 175 ft.

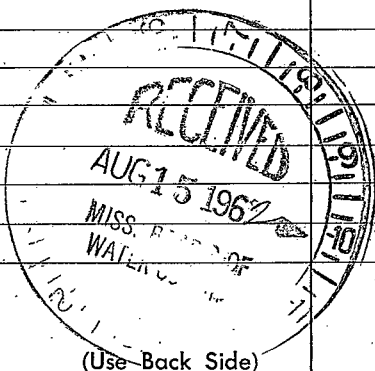

Well No.

Handwritten notes at the top of the page, including the word "SOUTH" and other illegible scribbles.

South
East
West
North

1944
1945
1946
1970