

Neshoba

F48

4-25-72

MISSISSIPPI BOARD OF WATER COMMISSIONERS 416 North State Street Jackson, Mississippi 39201

WATER WELL DRILLERS LOG

CODED

J FLOG #29

4-25

date well completed

1972 Singer - James Central Dir Neshoba

firm name

county well located

LANDOWNER:

Chata Development Company Philadelphia, Miss (mailing address)

description of formations encountered

from to

Table with 3 columns: description of formations encountered, from, to. Rows include: Red. Sandy Clay (0-30), Sand & Clay (30-63), Clay (63-106), Shaly Clay (106-185), Hard Clay (185-218), Sandy Clay (218-373), Clay (373-497), Shaly Shale (497-570), Sandy Shale (570-628), Sand (628-659), Clay & Sand streaks (659-760), Sand & Shale streaks (760-808), Sand (808-902), Fine Sand + Blk. chcls (902-932), Sand (932-1020), Clay (1020-1135), Rock (1135-1137), Clay (1137-1161), Rock (1161-1162), Clay (1162-1165), Rock (1165-1166), Clay (1166-1197), Rock (1197-1198), Hard Shale (1198-1246), Rock (1246-1248), Hard Clay (1248-1317)

WELL LOCATION:

sec. 30 T. 11 N. R. 11 E

miles of (distance) (direction) (nearest town)

WELL PURPOSE: Domestic (home, irrigation, municipal, industrial)

WELL COMPLETION DATA:

- (1) diameter (inches) 16"
(2) total depth (feet) 979'
(3) static water level (feet) 69 below top of ground.
(4) casing Steel 916' (material) (depth)
(5) screen 50' 923' (length) (depth to top)
(6) pump 25 HP 400 (yield gpm)
(7) electric log Yes
(8) how well bottom plugged Valve

CODED


MAY 20 1972 MISS. BD OF WATER COMM.

DRILLERS REMARKS:

②

If well telescopes please sketch and show depths.

GROUND LEVEL

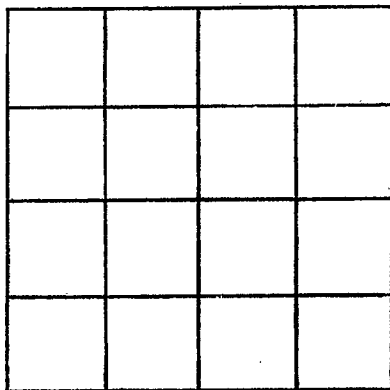

SECTION _____

Please indicate well location X.

ADDITIONAL INFORMATION

If more than one screen, show locations of each on sketch.