

NESHoba

F 49

12-14-73

MISSISSIPPI BOARD OF WATER COMMISSIONERS 416 North State Street Jackson, Mississippi 39201

CODED

WATER WELL DRILLERS LOG

12-14-73 19 date well completed

F. D. Roman NESHoba firm name county well located

LANDOWNER: R. L. ... (mailing address)

Table with 3 columns: description of formations encountered, from, to. Rows include Red clay, Sand, etc.

WELL LOCATION: sec. 34 T 110 N R 11 E S W 1/2 miles N of Williamsville

WELL PURPOSE: (home) Irrigation, municipal, industrial

- WELL COMPLETION DATA: (1) diameter (inches) 2 1/2 (2) total depth (feet) 93 (3) static water level (feet) 170 below top of ground (4) casing 2" 160 (5) screen 2" 220 (6) pump 2 220 (7) electric log 110 (8) how well bottom plugged


CODED

DRILLERS REMARKS:

DEC 19 1973

If well telescopes please sketch and show depths.

GROUND LEVEL

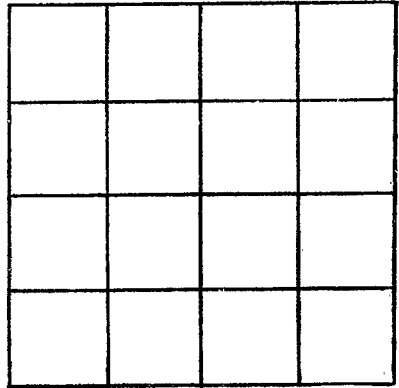

SECTION _____

Please indicate well location X.

ADDITIONAL INFORMATION

If more than one screen, show locations of each on sketch.