

NE SHOBA

F 200

MISSISSIPPI BOARD OF WATER COMMISSIONERS 416 North State Street Jackson, Mississippi 39201

WATER WELL DRILLERS LOG

March 1978 date well completed

Thomas & Son firm name

Neshoba county well located

LANDOWNER: State Highway Dept Philadelphia, Miss. (mailing address)

Table with 3 columns: description of formations encountered, from, to. Rows include: Fine clay, Blue Chalk, Fine Sand, Strs Chalk & fine sand, Hard Chalk, Sand, Lignite, Chalk w/ str Lignite, Blue Chalk, Sand, Crumbly Chalk, Rock, Fine Sand, Lignite, Chalk & silty sand, Course Sand, Strs Chalk & silt, Fine Sand, Course Sand.

WELL LOCATION: sec. 24 T 11 N R 11 E S W IN miles Phi. A. (distance) (direction) (nearest town)

WELL PURPOSE: Barn (home, irrigation, municipal, industrial)

- WELL COMPLETION DATA: (1) diameter (inches) 10 1/4" (2) total depth (feet) 690 (3) static water level (feet) 68 below top of ground. (4) casing 1/2" 190'4" (material) (depth) 4" if telescope see back. (5) screen 40' 640' (length) (depth to top) 2" stainless (size) (material) (6) pump 1 1/2 HP 15 yield gpm (type power) Elec (7) electric log Yes (yes or no) State Geo. Survey (organization running log) (8) how well bottom plugged Point

RECEIVED


MAY 17 1978

DRILLERS REMARKS:

MISS. BD. OF WATER COMMISSIONERS

If well telescopes please sketch and show depths.

GROUND LEVEL

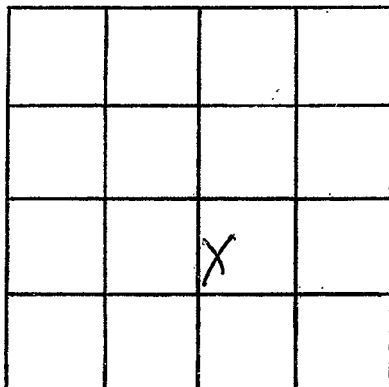

SECTION 24

Please indicate well location X.

ADDITIONAL INFORMATION

If more than one screen,  
show locations of each on sketch.