

NESHOBBA

3 BT

E Log #12

G 2
4-13-62

WATER WELL DRILLERS LOG

CODED

Neshoba
Stovada

Date: April 13, 1962, Driller: Robert & Ratliff Co. County: Stovada

Neshoba County School (Name)

(1) Owner of Land: Philadelpia
(Name)
Philadelpia, Miss.
(Address)

(2) Location: SW 1/4, NW 1/4, Sec. 32 11N 12E
T. R.
_____ miles _____ of _____
(distance) (direction) (Nearest Town)

(3) Topography: _____
(Hilly) (Flat) (Level)

(4) Purpose of Well: School
(Domestic Irrigation
Municipal, Industrial, Other)

Information upon completion of well:


- (1) Diameter: 8" inches.
- (2) Total Depth: 557' feet.
- (3) Water Level: 95' feet below top of ground.
- (4) Cased to: 646', Size 8"
- (5) Screen: Size 3", Length 50'
- (6) Were any formations sealed against pollution?
_____ yes, _____ no.

If YES depth of formation _____

Why _____

Drillers Remarks: _____

Description & Color of Materials Sand, Clay, Red Clay, Shell, etc.	Thick- ness Feet	Depth Feet
<u>Top Soil (Blue Clay)</u>	<u>0</u>	<u>22</u>
<u>Blue Clay</u>	<u>22</u>	<u>44</u>
<u>"</u>	<u>24</u>	<u>67</u>
<u>"</u>	<u>67</u>	<u>89</u>
<u>"</u>	<u>89</u>	<u>100</u>
<u>Sand</u>	<u>100</u>	<u>111</u>
<u>Sand - Sandy Shale</u>	<u>111</u>	<u>132</u>
<u>Sandy Shale</u>	<u>132</u>	<u>154</u>
<u>"</u>	<u>154</u>	<u>176</u>
<u>"</u>	<u>176</u>	<u>198</u>
<u>Shale</u>	<u>198</u>	<u>218</u>
<u>"</u>	<u>218</u>	<u>240</u>
<u>Shale - Rock</u>	<u>240</u>	<u>262</u>
<u>"</u>	<u>262</u>	<u>284</u>
<u>Shale</u>	<u>284</u>	<u>306</u>
<u>"</u>	<u>306</u>	<u>327</u>
<u>"</u>	<u>327</u>	<u>349</u>
<u>"</u>	<u>349</u>	<u>371</u>
<u>"</u>	<u>371</u>	<u>393</u>
<u>"</u>	<u>393</u>	<u>415</u>
<u>"</u>	<u>415</u>	<u>436</u>
<u>Shale - Rock</u>	<u>436</u>	<u>458</u>
<u>Shale</u>	<u>458</u>	<u>480</u>
<u>"</u>	<u>480</u>	<u>490</u>
<u>"</u>	<u>490</u>	<u>502</u>
<u>"</u>	<u>502</u>	<u>524</u>
<u>"</u>	<u>524</u>	<u>545</u>
<u>Shale - Sand & Streaks</u>	<u>545</u>	<u>567</u>
<u>Shale</u>	<u>567</u>	<u>589</u>
<u>"</u>	<u>589</u>	<u>611</u>
<u>"</u>	<u>611</u>	<u>632</u>
<u>Shale, Sand, Rocks</u>	<u>632</u>	<u>654</u>
<u>Fine Sand</u>	<u>654</u>	

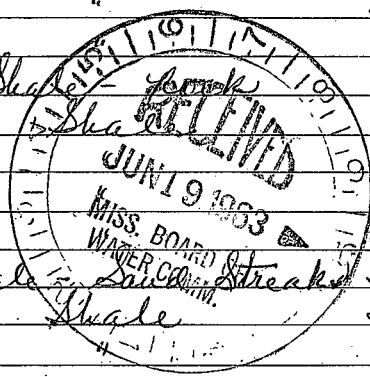

(Use Back Side)

(8)

Sand white course	676	698
"	698	724
Sandy shale rocks	724	736