

6 13T

Neshoba
G 8
3-68 CODED

MISSISSIPPI
BOARD OF WATER COMMISSIONERS
416 North State Street
Jackson, Mississippi 39201

WATER WELL DRILLERS LOG

3-9 1968 RR Nicholson Neshoba
date well completed firm name county well located

LANDOWNER: W.H. Clemond

description of formations encountered	from	to
Chalk & Sand	0'	100'
Chalk & dirt	60'	80'
blue dirt	80'	190'
Water Sand	190'	204'

Shila Miss.
(mailing address)

WELL LOCATION:

21 29 T-11 N R-12 E
4 1/2 miles East of Shila
(distance) (direction) (nearest town)

WELL PURPOSE: Home
(home, irrigation, municipal, industrial)


WELL COMPLETION DATA:

- (1) diameter (inches) 2"
- (2) total depth (feet) 204'
- (3) static water level (feet) 160' below top of ground.
- (4) casing 1 1/2" pipe 199' (material) (depth)
- (5) screen 2" (size) if telescope see back. 5' 204' (length) (depth to top)
- (6) pump 1/2 (HP) 4 (yield gpm)
- (7) electric log no (yes or no)
- (8) how well bottom plugged

MAY 14 1968

MISS. BD. OF WATER COMM.


CODEL

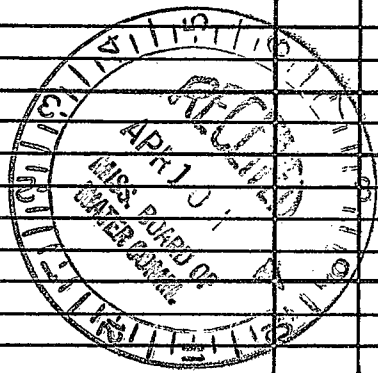

DRILLERS REMARKS: Good

If well telescopes please sketch and show depths.

GROUND LEVEL

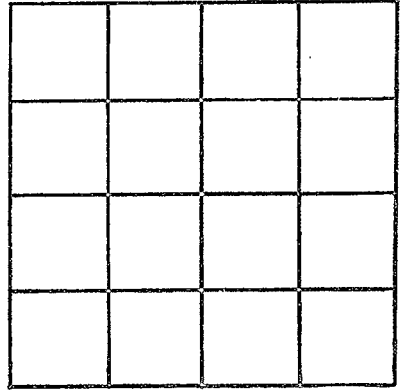

SECTION _____

Please indicate well location X.

ADDITIONAL INFORMATION

If more than one screen, show locations of each on sketch.