

3 13T

Cancelled
4/24/68
8R

NO 3/4/68
G 9
3-68 CODED

MISSISSIPPI
BOARD OF WATER COMMISSIONERS
416 North State Street
Jackson, Mississippi 39201

WATER WELL DRILLERS LOG

3/1 1968 Beck Smith Neshaba
date well completed firm name county well located

LANDOWNER: C. B. Young
Philadelphia
Mississippi 39350
(mailing address)

description of formations encountered	from	to
red clay	0	10
blue chalk	10	105
blue pepper sand	105	120

WELL LOCATION:
sec. 19 T 11 N S R 12 E W
1/2 miles N of Phila.
(distance) (direction) (nearest town)

WELL PURPOSE: home
(home, irrigation, municipal, industrial)

WELL COMPLETION DATA:

(1) diameter (inches) 2"

(2) total depth (feet) 120'

(3) static water level (feet) 40' below above top of ground.

(4) casing galv. 84' (material) (depth)
2" (size) If telescope see back.

(5) screen 24' (length) (depth to top)
24' (size) (material)

(6) pump 3/4 (HP) (yield gpm)
elec (type power)

(7) electric log no (yes or no)
(organization running log)


(8) how well bottom plugged

DRILLERS REMARKS:
open well

CODED

If well telescopes please
sketch and show depths.

GROUND LEVEL

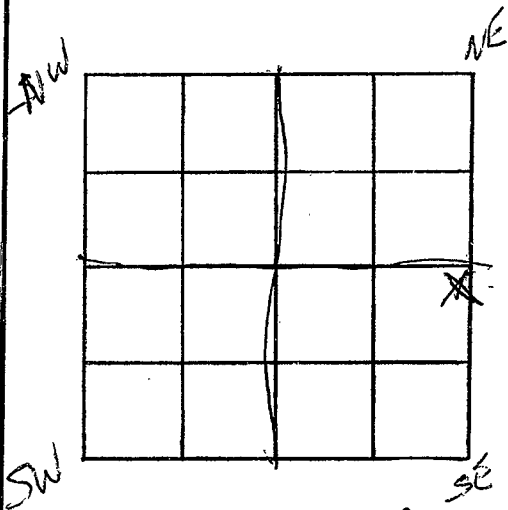

SECTION 19

Please indicate well location X.

ADDITIONAL INFORMATION

If more than one screen,
show locations of each on sketch.