

Cancelled  
4/24/68  
JTC

NESHABA  
G10  
2-68 CODED

MISSISSIPPI  
BOARD OF WATER COMMISSIONERS  
416 North State Street  
Jackson, Mississippi 39201

WATER WELL DRILLERS LOG

2/10 1968 Beck Smith Neshaba  
date well completed firm name county well located

LANDOWNER: Claude Tate  
Rt # 3  
Phila, Miss  
(mailing address)


description of formations encountered	from	to
red clay	0	12
blue chalk	12	101
red coarse sand	101	131

WELL LOCATION:  
sec. 14 T. 11 N. R. 12 E  
6 miles E of Phila  
(distance) (direction) (nearest town)

WELL PURPOSE: home  
(home, irrigation, municipal, industrial)

- WELL COMPLETION DATA:
- (1) diameter (inches) 2"
  - (2) total depth (feet) 131 ft
  - (3) static water level (feet) 45 below above top of ground.
  - (4) casing galv, 126, (material) (depth)  
2" (size) If telescope see back.
  - (5) screen 5', 126, (length) (depth to top)  
1/2", stainless steel (size) (material)
  - (6) pump 3/4 (HP) (yield gpm)  
Elec. (type power)
  - (7) electric log NO (yes or no)  
(organization running log)
  - (8) how well bottom plugged glide


CODED

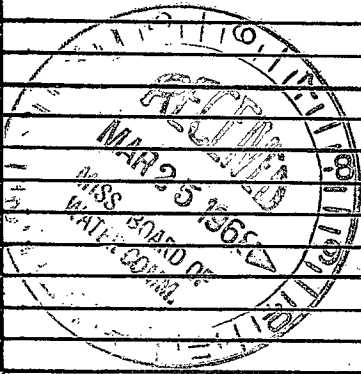

DRILLERS REMARKS:

If well telescopes please sketch and show depths.

GROUND LEVEL

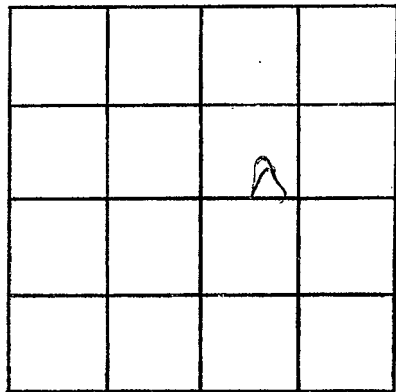

SECTION \_\_\_\_\_

Please indicate well location X.

ADDITIONAL INFORMATION

If more than one screen,  
show locations of each on sketch.