

3 13T

NESHOBIA

G 11 CODED

2/68

MISSISSIPPI BOARD OF WATER COMMISSIONERS
416 North State Street
Jackson, Mississippi 39201

WATER WELL DRILLERS LOG

2-15 1968 M.L. Day neshoba
date well completed 11-15-67 firm name M.L. Day county well located

LANDOWNER: B. F. Trington
Rhila miss R-4
(mailing address)

description of formations encountered from to

WELL LOCATION:
sec 31 T 11 N R 12 E
2 31 S 8 Rhila
(distance) (direction) (nearest town)

Blue dirt
to 20 ft mixed
dirt & sand to 40
Blue dirt to
90 ft sand 90
10.5 ft blue
dirt at 84 ft

WELL PURPOSE:
(home, irrigation, municipal, industrial)

WELL COMPLETION DATA: 9-15-67

- (1) diameter (inches) 2 in
- (2) total depth (feet) 10.5
- (3) static water level (feet) 25 below top of ground
- (4) casing (material) galvanized iron (depth) 7.5

(size) if telescope see back.

(5) screen none (length) (depth to top)

(6) pump 1/2 HP 890 GPM (HP) (yield gpm)
Elec (type power)


(7) electric log no (yes or no)

(organization running log)

(8) how well bottom plugged yes

DRILLERS REMARKS:

CODED

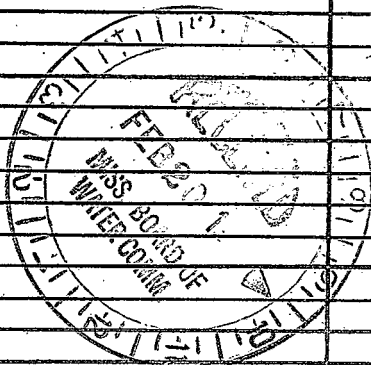

If well telescopes please sketch and show depths.

GROUND LEVEL

Handwritten notes and sketches in the left column, including a vertical line and various scribbles.

Handwritten notes at the top right of the page.

<i>Handwritten mark</i>	<i>Handwritten mark</i>	<i>Handwritten mark</i>	<i>Handwritten mark</i>
<i>Handwritten mark</i>	<i>Handwritten mark</i>	<i>Handwritten mark</i>	<i>Handwritten mark</i>
<i>Handwritten mark</i>	<i>Handwritten mark</i>	<i>Handwritten mark</i>	<i>Handwritten mark</i>
<i>Handwritten mark</i>	<i>Handwritten mark</i>	<i>Handwritten mark</i>	<i>Handwritten mark</i>

SECTION 31

Please indicate well location X.

ADDITIONAL INFORMATION

Multiple horizontal lines for additional information, with some handwritten notes and a large scribble.

If more than one screen, show locations of each on sketch.