

Corrected  
4/24/68  
RR

3 131

NESHABA  
G 12  
11-67

MISSISSIPPI  
BOARD OF WATER COMMISSIONERS  
416 North State Street  
Jackson, Mississippi 39201

WATER WELL DRILLERS LOG

Nov 23, 1967 date well completed  
Beck Smith firm name  
Neshoba county well located  
Phila, Miss

CODED

LANDOWNER:

Darrell Partridge  
Phila, Miss  
(mailing address)

description of formations encountered

from to

Blue chalk 0 50  
mic sand 50 95  
white coarse sand 95 110

WELL LOCATION:

sec. 33 T. 11 N. R. 12 E  
4 miles E of Phila  
(distance) (direction) (nearest town)


WELL PURPOSE:

home  
(home, irrigation, municipal, industrial)

WELL COMPLETION DATA:

- (1) diameter (inches) 2"
- (2) total depth (feet) 110
- (3) static water level (feet) 8 <sup>below</sup> above top of ground.
- (4) casing Galv, 105' (material) (depth)  
(size) if telescope see back.
- (5) screen 5' 105' (length) (depth to top)  
OOB, stainless steel (size) (material)
- (6) pump 1HP Jet (HP) (yield gpm)  
elec. (type power)
- (7) electric log No (yes or no)  
(organization running log)
- (8) how well bottom plugged back  
wash valve

CODED

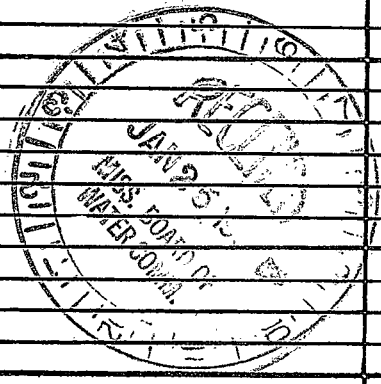

DRILLERS REMARKS:

If well telescopes please sketch and show depths.

GROUND LEVEL

		X	

SECTION 33

Please indicate well location X.

ADDITIONAL INFORMATION

If more than one screen, show locations of each on sketch.