

3 137

Neshoba
G 13
8-67

CODED

MISSISSIPPI
BOARD OF WATER COMMISSIONERS
416 North State Street
Jackson, Mississippi 39201

WATER WELL DRILLERS LOG

AUGUST 29 19 67 OGLETREE DRILLING NESHOPA
date well completed firm name county well located

LANDOWNER: HENRY CANNON

RT. 2

PHILADELPHIA, MISS.
(mailing address)

description of formations encountered	from	to
	RED CLAY	0
BLUE CHALK	12	125
GRAY SAND	125	168

WELL LOCATION:

sec. 27 T. 11 N S R. 12 E W
3 1/2 miles N.E. of PHILA.
(distance) (direction) (nearest town)


WELL PURPOSE: HOME
(home, irrigation, municipal, industrial)

WELL COMPLETION DATA:

- (1) diameter (inches) 2 1/2
- (2) total depth (feet) 168
- (3) static water level (feet) 5 below above top of ground.
- (4) casing Gav. 126
(material) (depth)
if telescope see back.
(size)
- (5) screen NONE
(length) (depth to top)
(size) (material)
- (6) pump 1/2 10
(HP) (yield gpm)
REA
(type power)
- (7) electric log
(yes or no)
(organization running log)
- (8) how well bottom plugged OPEN

CODED

DRILLERS REMARKS:

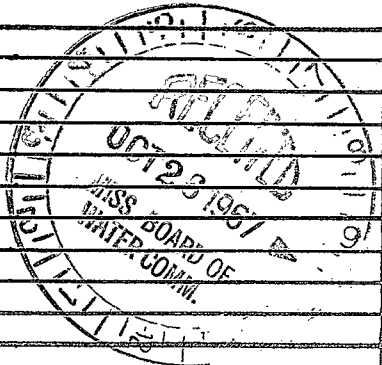

If well telescopes please sketch and show depths.

GROUND LEVEL

X			

SECTION 27

Please indicate well location X.

ADDITIONAL INFORMATION

If more than one screen, show locations of each on sketch.