

3 131

Neshoba
G 14
4-67

CODED

MISSISSIPPI
BOARD OF WATER COMMISSIONERS
416 North State Street
Jackson, Mississippi 39201

WATER WELL DRILLERS LOG

APRIL 11 19 67 OGLETREE DRILLING NESHOBA
date well completed firm name county well located

LANDOWNER: JEAN McDONALD
RT. 3, PHILADELPHIA, MISS.
(mailing address)

description of formations encountered	from	to
RED CLAM	0	35
White Chalk	35	55
Red Sand and Chalk	55	65
White Chalk	65	100
White Sand	100	131


WELL LOCATION:
sec. 8 T. 11 N. R. 12 E
S W
5 miles N. of PHILA.
(distance) (direction) (nearest town)

WELL PURPOSE: HOME USE
(home, irrigation, municipal, industrial)

WELL COMPLETION DATA:

- (1) diameter (inches) 2"
- (2) total depth (feet) 131
- (3) static water level (feet) 60 below above top of ground.
- (4) casing Gav. 126 (material), (depth)
- (size) if telescope see back.
- (5) screen 5' 131-126 (length), (depth to top)
1 1/4 Stainless Steel (size), (material)
- (6) pump 3/4 5 (HP), (yield gpm)
- REA (type power)
- (7) electric log NO (yes or no)
(organization running log)
- (8) how well bottom plugged Flank Valve


CODED

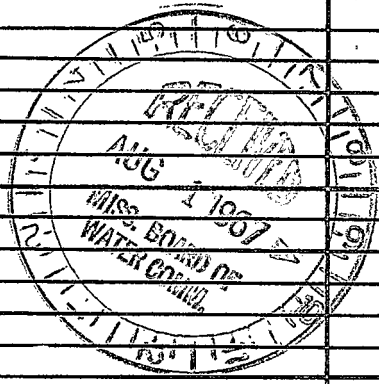

DRILLERS REMARKS:

If well telescopes please sketch and show depths.

GROUND LEVEL

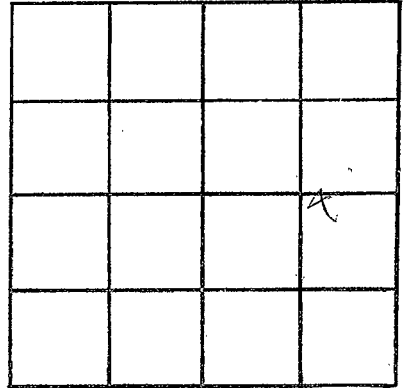

SECTION 8

Please indicate well location X.

ADDITIONAL INFORMATION

If more than one screen, show locations of each on sketch.