

3 13T

Neshoba  
G 15  
46-67

MISSISSIPPI  
BOARD OF WATER COMMISSIONERS  
416 North State Street  
Jackson, Mississippi 39201  
WATER WELL DRILLERS LOG

April 6 1967 Ogletree Drilling Neshoba  
date well completed firm name county well located

LANDOWNER: Jack Weatherford  
Rt. 2

description of formations encountered	from	to
Red Clay	0	15
White Sand	15	72

Philadelphia, Miss.  
(mailing address)

WELL LOCATION:


sec 22 T 11 N R 12 E  
S W  
3 miles E of Phil.  
(distance) (direction) (nearest town)

WELL PURPOSE: Home use  
(home, irrigation, municipal, industrial)

WELL COMPLETION DATA:

- (1) diameter (inches) 2"
- (2) total depth (feet) 72
- (3) static water level (feet) 35 below above top of ground.
- (4) casing 2" 67  
(material) (depth)  
if telescope see back.  
(size)
- (5) screen 5ft 72-67  
(length) (depth to top)  
1 1/2", Stainless Steel  
(size) (material)
- (6) pump 3/4 6  
(HP) (yield gpm)  
(type power)
- (7) electric log \_\_\_\_\_  
(yes or no)  
Ogletree Drilling  
(organization running log)
- (8) how well bottom plugged \_\_\_\_\_

DRILLERS REMARKS:

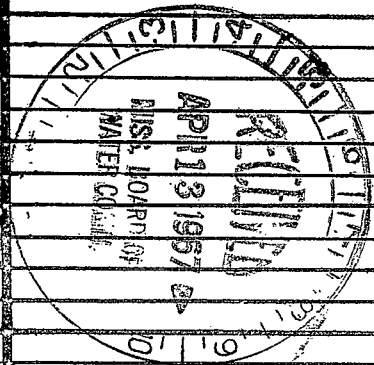

If well telescopes please sketch and show depths.

GROUND LEVEL

			X

SECTION 22

Please indicate well location X.

ADDITIONAL INFORMATION

If more than one screen,  
show locations of each on sketch.