

3 13T

Neshoba
G16
3-67

CODED

MISSISSIPPI
BOARD OF WATER COMMISSIONERS
416 North State Street
Jackson, Mississippi 39201

WATER WELL DRILLERS LOG

March 30 19 67 Ogletree Drilling Neshoba
date well completed firm name county well located

LANDOWNER: Theford Robertson
Philadelphia, Miss.

description of formations encountered	from	to
Red Clay	0	25
Blue Clay	25	85
White Sand	85	100

(mailing address)


WELL LOCATION:
sec. 14 T 11 N R 12 E
S W
1/2 miles N.E. of Phila.
(distance) (direction) (nearest town)

WELL PURPOSE: Home use
(home, irrigation, municipal, industrial)

WELL COMPLETION DATA:

- (1) diameter (inches) 2"
- (2) total depth (feet) 100
- (3) static water level (feet) 60 below above top of ground.
- (4) casing Gav. 95 (material) (depth)
if telescope see back.
(size)
- (5) screen 5ft. 100-95 (length) (depth to top)
1 1/2 Stainless steel (size) (material)
- (6) pump 3/4 5 (HP) (yield gpm)
(type power)
- (7) electric log (yes or no)
Ogletree Drilling (organization running log)
- (8) how well bottom plugged Fluvial
wave

CODED

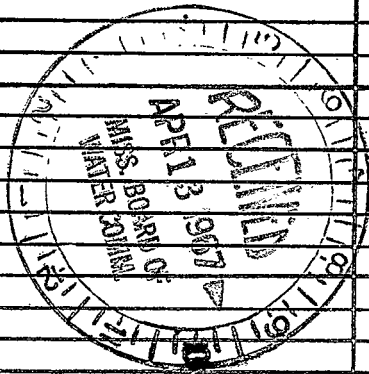

DRILLERS REMARKS:

If well telescopes please sketch and show depths.

GROUND LEVEL

			X

SECTION 24

Please indicate well location X.

ADDITIONAL INFORMATION

If more than one screen, show locations of each on sketch.