

3127

Neshoba
G18
1-67

CODED

MISSISSIPPI
BOARD OF WATER COMMISSIONERS
416 North State Street
Jackson, Mississippi 39201

WATER WELL DRILLERS LOG

January 21 19 67 Ogletree Drilling Neshoba
date well completed firm name county well located

LANDOWNER: Carnell Kirby

description of fomations encountered

from to

Route 3

Philadelphia, Miss.
(mailing address)

Red Clay 0 30
Blue Chalk 30 90
Gray Sand 90 131

WELL LOCATION:

sec. 22 T 11 N R. 12 E
S W
3 miles N.E. of Phila.
(distance) (direction) (nearest town)

WELL PURPOSE: Home use
(home, irrigation, municipal, industrial)

WELL COMPLETION DATA:

(1) diameter (inches) 2 1/4
(2) total depth (feet) _____
(3) static water level (feet) 80 below above top of ground.

(4) casing Gav. 126
(material) (depth)
(size) if telescope see back.

(5) screen 5 13'-126
(length) (depth to top)
1 1/4 Stainless Steel
(size) (material)


(6) pump 1/2 4
(HP) (yield gpm)
Electric
(type power)

(7) electric log _____
(yes or no)
(organization running log)

(8) how well bottom plugged Flush
save


DRILLERS REMARKS:

CODED

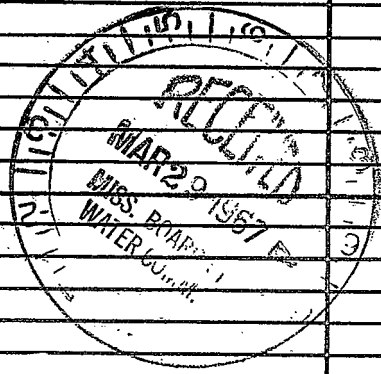

If well telescopes please sketch and show depths.

GROUND LEVEL

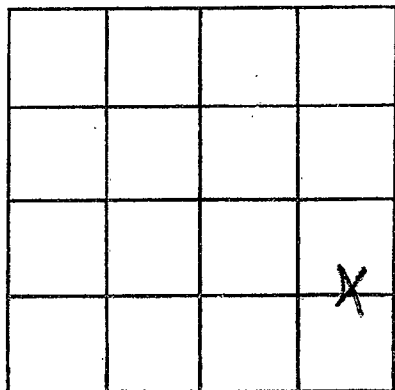

SECTION 22

Please indicate well location X.

ADDITIONAL INFORMATION

If more than one screen,
show locations of each on sketch.