

G 20
9-26-60

3 131
CODE WATER WELL DRILLERS LOG

Date: 9-26, 1960, Driller: R R Nicholas, County: Nebraska
(Name)


(1) Owner of Land:	Description & Color of Materials Sand, Clay, Red Clay, Shell, etc.	Thick- ness Feet	Depth Feet
Nebraska school (Name) P. H. Hays - mine	Sand & clay	1	80
(Address) 32 1112	moist sand	80	160
(2) Location: 1/4, 3/4, Sec. T R	blue dirt	100	290
2 miles north of Phila (distance) (direction) (Nearest Town)	water sand	290	315
(3) Topography: Hilly (Hilly) (Flat) (Level)			
(4) Purpose of Well: School use (Domestic Irrigation Municipal, Industrial, Other)			

Information upon completion of well:

- (1) Diameter 4 inches.
- (2) Total Depth 315 feet.
- (3) Water Level 65 feet below top of ground.
- (4) Cased to 105, Size 3"
- (5) Screen: Size open, Length _____
- (6) Were any formations sealed against pollution?
_____ yes, _____ no.

If YES depth of formation _____
Why _____

Drillers Remarks: good well

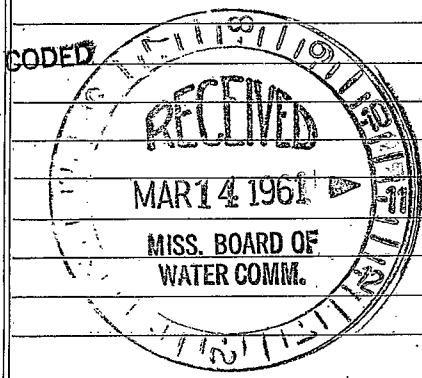

(Use Back Side)

Well No.

