

3 131

Neshoba

X G-21

8-67 CODED

MISSISSIPPI BOARD OF WATER COMMISSIONERS
416 North State Street
Jackson, Mississippi 39201

WATER WELL DRILLERS LOG

AUGUST 1 19 67 OGLETREE DRILLING NESHOBA
date well completed firm name county well located

LANDOWNER: RUSH

description of formations encountered

from to

PT. 2

PHILADELPHIA, MISS.
(mailing address)

RED CLAY 0 12
RED SAND 12 100
BLUE CHALK 100 150
GRAY SAND 150 178

WELL LOCATION:

sec. 34 T 10 N R 12 E
S W
3 1/2 miles So. EAST of PHILA.
(distance) (direction) (nearest town)

WELL PURPOSE: HOME USE
(home, irrigation, municipal, industrial)

WELL COMPLETION DATA:

(1) diameter (inches) 2"
(2) total depth (feet) 178
(3) static water level (feet) 61 below above top of ground.
(4) casing GAV. 168
(material) (depth)

CODED

(size) if telescope see back.

(5) screen 10' 168
(length) (depth to top)
1 1/4 STAINLESS STEEL
(size) (material)

(6) pump 1 6
(HP) (yield gpm)


REA
(type power)

(7) electric log NO
(yes or no)

(organization running log)


(8) how well bottom plugged FLUSH VALVE

DRILLERS REMARKS:

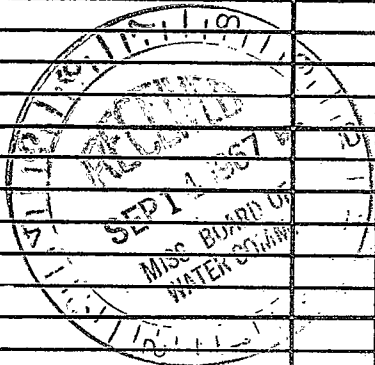

If well telescopes please sketch and show depths.

GROUND LEVEL

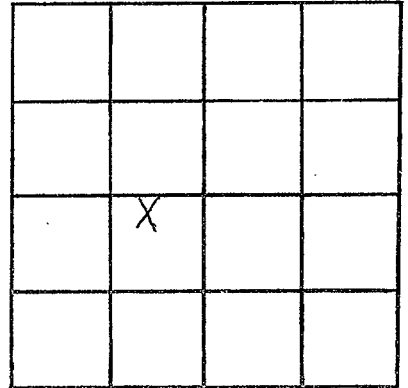

SECTION 34

Please indicate well location X.

ADDITIONAL INFORMATION

If more than one screen, show locations of each on sketch.