

NESHOSA

MISSISSIPPI BOARD OF WATER COM

G 22
9-7-60

6 13T

WATER WELL DRILLERS LOG

7302

Date: Sept 7, 1960 ^{CODED}

Driller: TS McComb

County Neshoba

(Name)

(1) Owner of Land: James S. ...
(Name)

Philadelphia Miss
(Address)

(2) Location: 1/4, 29 11 12 Sec. T R

3 miles E of Phil...
(distance) (direction) (Nearest Town)

(3) Topography: L H Y
(Hilly) (Flat) (Level)

(4) Purpose of Well: Domestic
(Domestic Irrigation, Municipal, Industrial, Other)

Description & Color of Materials
Sand, Clay, Red Clay, Shell, etc.

Thick-
ness
Feet

Depth
Feet

Red clay 10
Pink sand 52
Pink sand 13
Yellow sand 10

85

Information upon completion of well:

(1) Diameter 2 inches.

(2) Total Depth 85 feet.

(3) Water Level 42 feet below top of ground.

(4) Cased to 29, Size 2


(5) Screen: Size 1/4, Length 6

(6) Were any formations sealed against pollution?
_____ yes, _____ no.

If YES depth of formation _____

Why _____

Drillers Remarks: _____

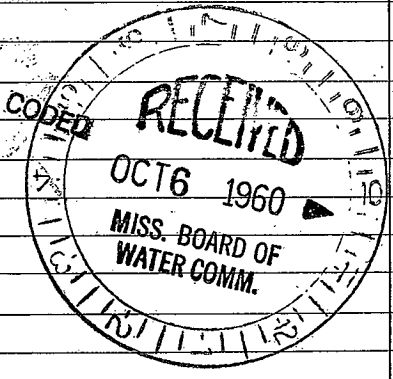

(Use Back Side)

Well No.

