

NEHOBA
G 23

WATER WELL DRILLERS LOG

2-13-61 CODE

Date: 3-13, 1961, Driller: Hester Ogletree County Neshoba
(Name)

| | Description & Color of Materials Sand, Clay, Red Clay, Shell, etc. | Thick- ness Feet | Depth Feet |
|---|---|------------------------|---------------|
| (1) Owner of Land: <u>Sammy Hancock</u> (Name) <u>RF 6</u> (Address) <u>7 11 12</u> | <u>15 ft. clay</u> | | |
| (2) Location: <u>1/4</u> , <u>1/4</u> , Sec. <u>T</u> <u>R</u> <u>5</u> miles <u>north</u> , of <u>Philas</u> (distance) (direction) (Nearest Town) | <u>62 ft. sandy chalk</u> | | |
| (3) Topography: <u>Hilly</u> (Hilly) (Flat) (Level) | <u>16 ft. water sand</u> | | |
| (4) Purpose of Well: <u>Home use</u> (Domestic Irrigation Municipal, Industrial, Other) | | | |


Information upon completion of well:

- (1) Diameter 4 1/2 inches.
- (2) Total Depth 90 feet.
- (3) Water Level 52 feet below top of ground.
- (4) Cased to 84, Size 2 in.
- (5) Screen: Size 1 1/2, Length 6 ft. CODED
- (6) Were any formations sealed against pollution?
_____ yes, _____ no.

If YES depth of formation _____

Why _____

Drillers Remarks: _____

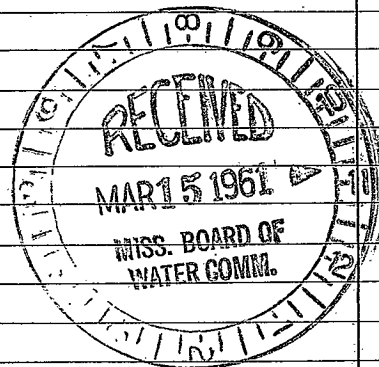

(Use Back Side)

Well No.

