

NEENOKA
G 24
7-14-60

613J

E 302

WATER WELL DRILLERS LOG

Date: 7-14 1960, Driller: R R Nicholas, County: Neeshoba
(Name)

(1) Owner of Land: R E Gossard
(Name)
Phila Miss
(Address)
24 11 12

(2) Location: 1/4, 1/4, Sec. T R,
7 miles east of Phila,
(distance) (direction) (Nearest Town)

(3) Topography: level
(Hilly) (Flat) (Level)

(4) Purpose of Well: Home use
(Domestic Irrigation
Municipal, Industrial, Other)

Description & Color of Materials Sand, Clay, Red Clay, Shell, etc.	Thick- ness Feet	Depth Feet
<u>Small clay</u>	<u>1</u>	<u>19</u>
<u>blue dirt</u>	<u>19</u>	<u>100</u>
<u>Shell rock</u>	<u>100</u>	<u>110</u>
<u>Black</u>	<u>110</u>	<u>150</u>
<u>Blue & uncolored</u>	<u>150</u>	<u>385</u>
<u>Black dirt & sand</u>	<u>385</u>	<u>400</u>
<u>Water sand</u>	<u>400</u>	<u>420</u>

Information upon completion of well:

(1) Diameter 4 1/2 inches.

(2) Total Depth 420 feet.

(3) Water Level 50 feet below top of ground.


(4) Cased to 147, Size 2"

(5) Screen: Size open well, Length _____

(6) Were any formations sealed against pollution?
_____ yes, X no.

If YES depth of formation _____
Why _____

Drillers Remarks: this well
Pump no sand
at all cleared in
45 minutes

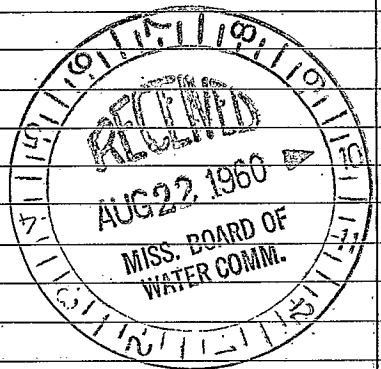

(Use Back Side)

Well No.

