

NE SHOBA
H G 25

6 13 T
WATER WELL DRILLERS LOG

Date: 10-15-62, 1962 Driller: M & Ray County: Neshoba
10-15-62 (Name)

(1) Owner of Land: Geo. Blumson
(Name)
Phila. Miss. R # 2
(Address)
(2) Location: 1/4, 1/4, Sec. T R
1 11 12
1/4 miles East of Phila.
(distance) (direction) (Nearest Town)
(3) Topography: (Hilly) (Flat) (Level)
(4) Purpose of Well: Domestic
(Domestic Irrigation
Municipal, Industrial, Other)

Description & Color of Materials
Sand, Clay, Red Clay, Shell, etc.
Red sand to 15 ft
Blue clay to 11
Coarse blue sand to 102 ft
Sand 85% 102


Thick-
ness
Feet
Depth
Feet

Information upon completion of well:

(1) Diameter: 2 inches.
(2) Total Depth: 102 feet.
(3) Water Level: 70 feet below top of ground.
(4) Cased to: 96 ft, Size: 2
(5) Screen: Size: 1/2 inch length: 10 ft
(6) Were any formations sealed against pollution?
yes, no.

If YES depth of formation _____
Why _____
Drillers Remarks: _____

MODEL

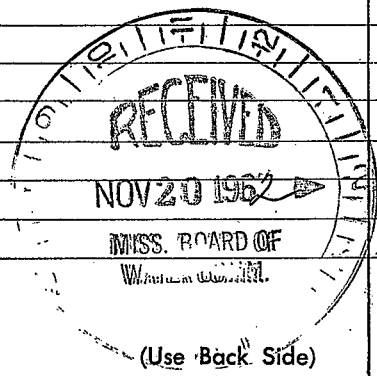

Well No.

10-12-12

11/11/12

10-12-12

11/11/12
11/11/12
