

NESHOBA

MISSISSIPPI BOARD OF WATER COMMISSIONERS

G26

6 13T
CODED WATER WELL DRILLERS LOG

B 5

9-13-61

Date: 9/13, 1961, Driller: Hester Ogletree County Neshoba
(Name)

(1) Owner of Land: <u>Hope Well school</u> (Name)	Description & Color of Materials Sand, Clay, Red Clay, Shell, etc.	Thick- ness Feet	Depth Feet
<u>phila, miss</u> (Address)	<u>15 ft. clay</u>		
(2) Location: <u>NW 1/4, NE 28 11 12</u> T. R.	<u>160 ft. blue clay</u>		
<u>3 miles East</u> of <u>phila</u> (distance) (direction) (Nearest Town)	<u>40 ft. water sand</u>		
(3) Topography: <u>hilly</u> (Hilly) (Flat) (Level)			
(4) Purpose of Well: <u>School</u> (Domestic Irrigation Municipal, Industrial, Other)			


Information upon completion of well:

- (1) Diameter 4 inches.
- (2) Total Depth 215 feet.
- (3) Water Level 70 feet below top of ground.
- (4) Cased to 105, Size 2 in.
- (5) Screen: Size _____, Length _____.
- (6) Were any formations sealed against pollution?
_____ yes, _____ no.

If YES depth of formation _____
Why _____

Drillers Remarks: _____

CODED

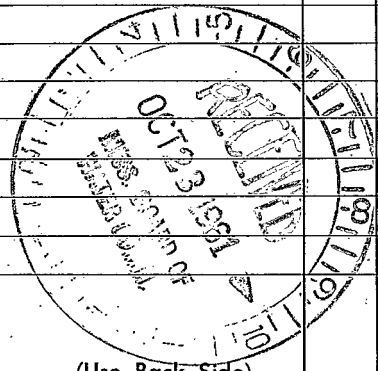

(Use Back Side)

Well No.

