

NESTHOBA

MISSISSIPPI BOARD OF WATER COMMISSIONERS

G 28

6 131
CODED

WATER WELL DRILLERS LOG

9-17-62

Date: 9-17, 1962 Driller: M. J. King County Neshoba

(Name)

(1) Owner of Land: Wm. Blount
(Name)
State R# 2
(Address)

(2) Location: 2 11 12
1/4, 1/4, Sec. T. R.
7 miles East of Phila
(distance) (direction) (Nearest Town)

(3) Topography: (Hilly) (Flat) (Level)

(4) Purpose of Well: Domestic
(Domestic Irrigation
Municipal, Industrial, Other)

Description & Color of Materials Sand, Clay, Red Clay, Shell, etc.	Thick-ness Feet	Depth Feet
<u>Casein sealed</u>		<u>105 ft</u>
<u>Gravel</u>		<u>190 ft</u>
<u>Blue sandstone</u>		
<u>all the way</u>		
<u>down</u>		


Information upon completion of well:

- (1) Diameter 2 inches.
- (2) Total Depth 210 feet.
- (3) Water Level 80 feet below top of ground.
- (4) Cased to 105, Size 2
- (5) Screen: Size none Length _____
- (6) Were any formations sealed against pollution?
 yes, no.

If YES depth of formation _____
Why _____

Drillers Remarks: Blue clay
all the way
to 190 ft casing
sealed at 105 ft

CODED

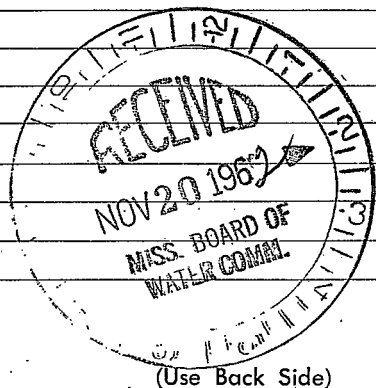

Well No.

