

NESHOPA

MISSISSIPPI BOARD OF WATER COMMISSIONERS

G 29

CODED

WATER WELL DRILLERS LOG

10-2-62

Date: 10-2-1962 Driller: M. L. Pugh County: Neshoba

(Name)

(1) Owner of Land: Paul Walker

(Name)

Phila Miss 19# 2

(Address)

(2) Location: 1/4, 1/4, Sec. T R

14-11-12

5 miles East of Phila

(distance) (direction) (Nearest Town)

(3) Topography: [check] (Hilly) (Flat) (Level)

(4) Purpose of Well: Domestic (Domestic Irrigation, Municipal, Industrial, Other)

Description & Color of Materials Sand, Clay, Red Clay, Shell, etc

Thick-ness Feet

Depth Feet

Yellow dirt to 15 ft depth Blue clay to 105 ft. Ph. 6 part sand mixed to 125 ft sand 125x140

Information upon completion of well:


- (1) Diameter 2 inches.
(2) Total Depth 140 feet.
(3) Water Level 65 feet below top of ground.
(4) Cased to 134, Size 2 in.
(5) Screen: Size 1/2 inch Length 10 ft.
(6) Were any formations sealed against pollution? yes, [check] no.

If YES depth of formation

Why

Drillers Remarks:

CODED

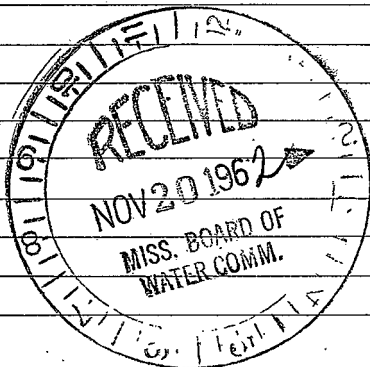

(Use Back Side)

Well No.

