

CODED

Neshoba Co
G-31
6-69

MISSISSIPPI
BOARD OF WATER COMMISSIONERS
416 North State Street
Jackson, Mississippi 39201

WATER WELL DRILLERS LOG

6-12 1969 Beck Smith Neshoba
date well completed firm name county well located

LANDOWNER: Alvin Anderson

description of formations encountered

from to

Rt. 1

Philas. Miss.
(mailing address)

red clay 0 100
blue clay 100 156
gray sand 156 165

WELL LOCATION:

sec. 2 - T. 11 N. R. 12. E.
S. W.
8 miles E of Phila
(distance) (direction) (nearest town)

WELL PURPOSE: home
(home, irrigation, municipal, industrial)

WELL COMPLETION DATA:

- (1) diameter (inches) 2"
- (2) total depth (feet) 168
- (3) static water level (feet) 65 ^{below} above top of ground.
- (4) casing galv. 163
(material) (depth)
2" if telescope see back.
(size)
- (5) screen 5ft 163
(length) (depth to top)
008, standard steel
(size) (material)
- (6) pump 1HP
(HP) (yield gpm)
Elec.
(type power)
- (7) electric log no
(yes or no)

(organization running log)

(8) how well bottom plugged Back
wash valves


AUG 12 1969

DRILLERS REMARKS:

MISS. BD. OF
WATER COMM.

If well telescopes please sketch and show depths.

GROUND LEVEL

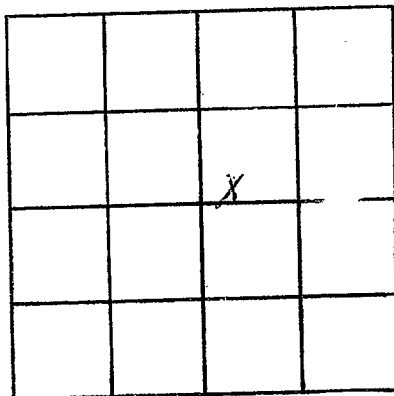

SECTION 2

Please indicate well location X.

ADDITIONAL INFORMATION

If more than one screen, show locations of each on sketch.