

Coded

Deshoba  
G32  
8-15-69

MISSISSIPPI  
BOARD OF WATER COMMISSIONERS  
416 North State Street  
Jackson, Mississippi 39201

WATER WELL DRILLERS LOG

8-15 1969 J.R. Nicholson Deshoba  
date well completed firm name county well located

LANDOWNER:	description of formations encountered	from	to
<u>Philis</u>	<u>Chalk &amp; dirt</u>	<u>0</u>	<u>12</u>
<u>Miss</u>	<u>blue dirt</u>	<u>12</u>	<u>57</u>
(mailing address)	<u>mix blue dirt &amp; sand</u>	<u>57</u>	<u>80</u>
WELL LOCATION:	<u>blue dirt</u>	<u>80</u>	<u>84</u>
sec. <u>19</u> T. <u>11</u> N. R. <u>12</u> E	<u>Mix sand &amp; s.</u>	<u>84</u>	<u>160</u>
<u>in town</u> miles <u>1</u> S of <u>Philis</u>	<u>water sand coarse</u>	<u>160</u>	<u>189</u>
(distance) (direction) (nearest town)			
WELL PURPOSE: <u>industrial</u>			
(home, irrigation, municipal, industrial)			
WELL COMPLETION DATA:			
(1) diameter (inches) <u>6 1/2"</u>			
(2) total depth (feet) <u>189</u>			
(3) static water level (feet) <u>30</u> below top of ground.			
(4) casing <u>Black P.</u> <u>168</u>			
(material) (depth)			
<u>4"</u> if telescope see back.			
(size)			
(5) screen <u>20"</u> <u>189'</u>			
(length) (depth to top)			
<u>2"</u> <u>Steel</u>			
(size) (material)			
(6) pump <u>3</u> <u>70</u>			
(HP) (yield gpm)			
<u>Elect.</u>			
(type power)			
(7) electric log <u>no</u>			
(yes or no)			
(organization running log)			
(8) how well bottom plugged <u>point</u>			

SEP - 7 1969


MISS. Bd. of WATER COMMISSIONERS

DRILLERS REMARKS:

⊗

If well telescopes please sketch and show depths.

GROUND LEVEL

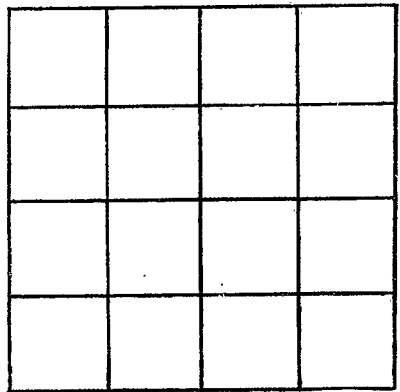

SECTION 19

Please indicate well location X.

ADDITIONAL INFORMATION

A series of horizontal lines for recording additional information.

If more than one screen, show locations of each on sketch.