

Meshoba  
G 34  
5-18-70

MISSISSIPPI  
 BOARD OF WATER COMMISSIONERS  
 416 North State Street  
 Jackson, Mississippi 39201

COD FD

WATER WELL DRILLERS LOG

5-18 19 70 Oglethead Dr. Memphis Meshoba  
 date well completed firm name county well located

LANDOWNER:  
Bill Masingale  
Rt. 3, Phila Min  
 (mailing address)

description of formations encountered	from	to
	<u>Red clay</u>	<u>0</u>
<u>Blue shalk</u>	<u>20</u>	<u>300</u>
<u>White sand</u>	<u>300</u>	<u>346</u>

WELL LOCATION:  
 sec. 2 T. 11 N. R. 12 E.  
5 miles north of Phila.  
 (distance) (direction) (nearest town)

WELL PURPOSE:  
 (home, irrigation, municipal, industrial)

WELL COMPLETION DATA:

(1) diameter (inches) 2"

(2) total depth (feet) 346

(3) static water level (feet) 65 below above top of ground.

(4) casing Galv., 336  
 (material) (depth)  
NONE if telescope see back.  
 (size)

(5) screen 10', 346-336  
 (length) (depth to top)  
1/2", Stainless steel  
 (size) (material)

(6) pump 1/2, 5  
 (HP) (yield gpm)  
Elec.  
 (type power)

(7) electric log NO  
 (yes or no)

(organization running log)

(8) how well bottom-plugged Painted


DRILLERS REMARKS:

JUN 22 1970

MISS. BD. OF  
 WATER COMM.

If well telescopes please sketch and show depths.

GROUND LEVEL

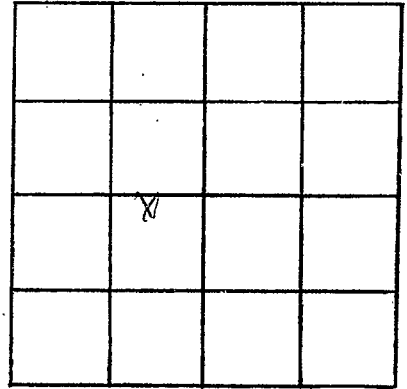

SECTION \_\_\_\_\_

Please indicate well location X.

ADDITIONAL INFORMATION

If more than one screen,  
show locations of each on sketch.