

G²-40
8-20-64

6131
CODED

WATER WELL DRILLERS LOG


Date: 8-20, 1964, Driller: MERRITT Spilling, County WESHOBAMA
(Name)

(1) Owner of Land: DAN Mc LAURIN
(Name)
PHILADELPHIA, MISS.
(Address)
171112
(2) Location: 1/4, 1/4, Sec. T R
2 miles EAST, of PHILADELPHIA
(distance) (direction) (Nearest Town)
(3) Topography: Hilly
(Hilly) (Flat) (Level)
(4) Purpose of Well: DOMESTIC
(Domestic Irrigation
Municipal, Industrial, Other)

Description & Color of Materials Sand, Clay, Red Clay, Shell, etc.	Thick- ness Feet	Depth Feet
Red CLAY	0	5-
White CLAY	5	10-
Yellow clay & SAND	15	31
FINE white SAND	31	63
COARSE white SAND	63	86
FINE white SAND	86	105

Information upon completion of well:

(1) Diameter 2 - inches.
(2) Total Depth 10.5 feet.
(3) Water Level 63 feet below top of ground.
(4) Cased to 84, Size 2"
(5) Screen: Size 2", Length 5'
(6) Were any formations sealed against pollution?
yes, no.

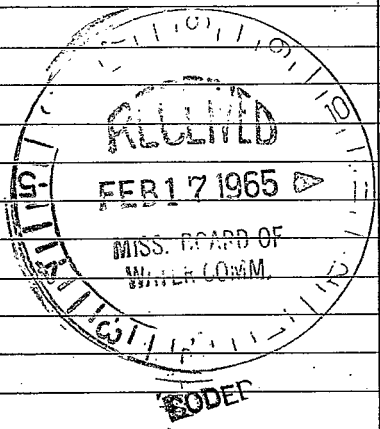

If YES depth of formation _____
Why _____

Drillers Remarks: _____

(Use Back Side)

Well No.

1914

1915

1916

1917

1918

1919

1920

1921

1922

1923