

NESHOPA
G45

Date: August 19 1966 Driller: M. J. Reitz County: C

Neshoba Co. G45

(Name)

(1) Owner of Land: M. J. Callahan
(Name)
Phillipsville, Miss
(Address)

(2) Location: 1/4, 1/4, Sec. 5 T12
2 1/2 miles NE of Phillipsville
(distance) (direction) (Nearest Town)

(3) Topography: ✓
(Hilly) (Flat) (Level)

(4) Purpose of Well:
(Domestic Irrigation
Municipal, Industrial, Other)

Description & Color of Materials
Sand, Clay, Red Clay, Shell, etc.

Shale 11 ft
Sand 120 ft
12-17 1/2 ft
Water bearing zone
50-75 ft

Information upon completion of well:

(1) Diameter 2 inches.

(2) Total Depth 75 feet.

(3) Water Level 50 feet below top of ground.

(4) Cased to 70, Size _____

(5) Screen: Size 1 1/4, Length 5 ft

(6) Were any formations sealed against pollution?


_____ yes, ✓ no.

If YES depth of formation _____

Why _____

Drillers Remarks: _____

CODED

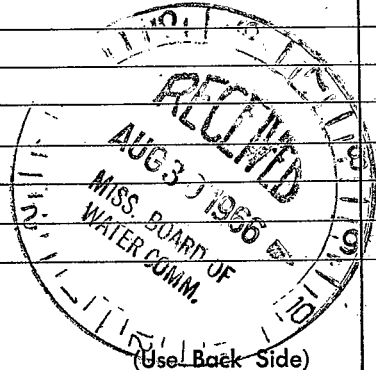

Well No. _____

