

NESHOBA  
G 46  
4-1-71

MISSISSIPPI  
BOARD OF WATER COMMISSIONERS  
416 North State Street  
Jackson, Mississippi 39201

**CODED**

WATER WELL DRILLERS LOG

4-1 1971 RR Nicholson Neshoba  
date well completed firm name county well located

LANDOWNER: B G Jackson  
Child  
Miss  
(mailing address)

description of formations encountered	from	to
<u>Clay Chalk</u>	<u>0</u>	<u>19</u>
<u>Shell &amp; Blue dirt</u>	<u>19</u>	<u>25</u>
<u>Blue dirt</u>	<u>25</u>	<u>100</u>
<u>Water Sand</u>	<u>100</u>	<u>115</u>

WELL LOCATION:  
sec. 35 T. 10 N. R. 13 E  
4 miles East of Shiloh  
(distance) (direction) (nearest town)

WELL PURPOSE: home  
(home, irrigation, municipal, industrial)

- WELL COMPLETION DATA:
- diameter (inches) 4 1/4
  - total depth (feet) 113
  - static water level (feet) 28 below above top of ground.
  - casing galv. 110'  
(material) (depth)  
2"  
(size) if telescope see back.
  - screen 5' 115'  
(length) (depth to top)  
1 1/4" steel  
(size) (material)
  - pump 1/2 7  
(HP) (yield gpm)  
Elect.  
(type power)
  - electric log yes  
(yes or no)

**CODED**

MAY 3 - 1971

MISS. BD. OF  
WATER COMM.


DRILLERS REMARKS:

(8) how well bottom plugged Screen

(organization running log)

If well telescopes please sketch and show depths.

GROUND LEVEL

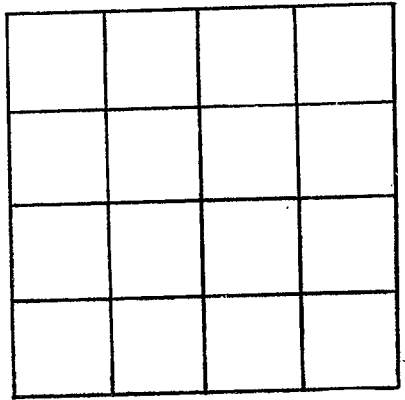

SECTION \_\_\_\_\_

Please indicate well location X.

ADDITIONAL INFORMATION

If more than one screen, show locations of each on sketch.