

NE SHOBA
547
5-1-71

MISSISSIPPI
 BOARD OF WATER COMMISSIONERS
 416 North State Street
 Jackson, Mississippi 39201

CODED

WATER WELL DRILLERS LOG

5-1-71 1971 Beck Smith Neshoba
 date well completed firm name county well located

LANDOWNER: Jena Farmer
Phila. Miss
39350
 (mailing address)

description of formations encountered	from	to
<u>red clay</u>	<u>0</u>	<u>85</u>
<u>blue chalk</u>	<u>85</u>	<u>140</u>
<u>gray sand</u>	<u>140</u>	<u>200</u>

WELL LOCATION:
 sec. 1 T. 11 N. R. 12 E
 (distance) miles (direction) of (nearest town)

WELL PURPOSE: home
 (home, irrigation, municipal, industrial)

- WELL COMPLETION DATA:
- diameter (inches) 2"
 - total depth (feet) 200'
 - static water level (feet) 60 ^{below} _{above} top of ground.
 - casing galv. 95'
 (material) (depth)
2" if telescope see back.
 (size)
 - screen open
 (length) (depth to top)
 (size) (material)
 - pump 1/2 6
 (HP) (yield gpm)
elec.
 (type power)
 - electric log -
 (yes or no)
 (organization running log)
 - how well bottom plugged -

CODED


JUN 10 1971

MISS. Bd. OF WATER COMMISSIONERS

DRILLERS REMARKS:

If well telescopes please sketch and show depths.

GROUND LEVEL

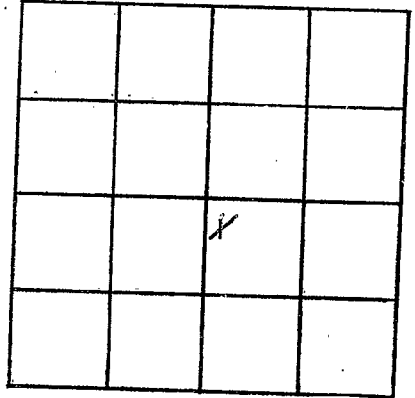

SECTION _____

Please indicate well location X.

ADDITIONAL INFORMATION

screen,
f each on sketch.