

Neshoba  
G 49  
10-4-71

MISSISSIPPI  
BOARD OF WATER COMMISSIONERS  
416 North State Street  
Jackson, Mississippi 39201

**CODED**

WATER WELL DRILLERS LOG

10-4-1971 date well completed  
 J. J. Williams firm name  
 Neshoba county well located

LANDOWNER: Phila Park

description of formations encountered	depth	
	from	to
<u>clay</u>	<u>0</u>	<u>12</u>
<u>shale &amp; mudstone</u>	<u>12</u>	<u>30</u>
<u>limestone</u>	<u>30</u>	<u>35</u>
<u>limestone</u>	<u>35</u>	<u>125</u>

(mailing address)

WELL LOCATION:  
 sec. 14 T. 11 N R. 12 E  
 S W  
1/2 miles V of Shuba  
 (distance) (direction) (nearest town)

WELL PURPOSE:  
 (home, irrigation, municipal, industrial)

WELL COMPLETION DATA:

- (1) diameter (inches) 4
- (2) total depth (feet) 125
- (3) static water level (feet) 15 below top of ground.
- (4) casing Plexiglas (material) 125 (depth)  
 \_\_\_\_\_ if telescope see back.  
 (size)
- (5) screen 2 (length) 125 (depth to top)  
2 (size) limestone sand (material)
- (6) pump 1/2 (HP) 2 (yield gpm)  
PEIT (type power)
- (7) electric log \_\_\_\_\_  
 (yes or no)  
 \_\_\_\_\_ (organization running log)
- (8) how well bottom plugged \_\_\_\_\_


**CODED**

NOV 4 - 1971

DRILLERS REMARKS:

If well telescopes please  
sketch and show depths.

Slot  
GROUND LEVEL

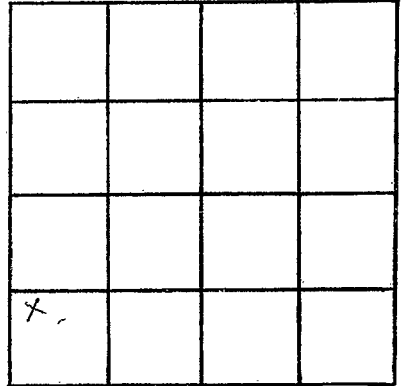

SECTION \_\_\_\_\_

Please indicate well location X.

ADDITIONAL INFORMATION

If more than one screen,  
show locations of each on sketch.