

NESHOMA

652

7-22-74

MISSISSIPPI BOARD OF WATER COMMISSIONERS

416 North State Street
Jackson, Mississippi 39201

CODED

WATER WELL DRILLERS LOG

July 22, 1974 Beek Smith Neshoma
Date well completed firm name county well located

LANDOWNER:

James Moore
Phila Miss
(mailing address)

description of formations encountered

from to

red clay 0 31
Blue chert 31 90
gray sand 90 115

WELL LOCATION:

sec. 1 T. 11 N. R. 12 E. S. 4 W.
4 miles NE of Phila
(distance) (direction) (nearest town)

WELL PURPOSE: home
(home, irrigation, municipal, industrial)


WELL COMPLETION DATA:

- (1) diameter (inches) 2
- (2) total depth (feet) 115
- (3) static water level (feet) 60 below top of ground.
- (4) casing galv. 110 (material) (depth)
2" (size) If telescope see back.
- (5) screen 5' 110 (length) (depth to top)
008, stainless steel (size) (material)
- (6) pump 1 HP 6 (HP) (yield gpm)
elec (type power)
- (7) electric log (yes or no)

(organization running log)


(8) how well bottom plugged back
Wash Valve

DRILLERS REMARKS:

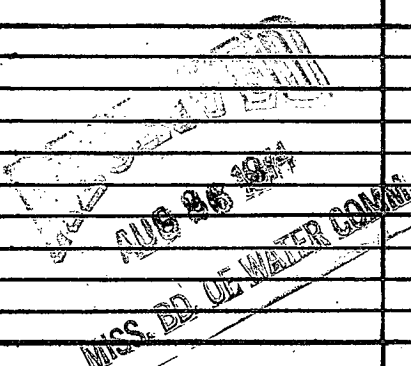

If well telescopes please sketch and show depths.

GROUND LEVEL

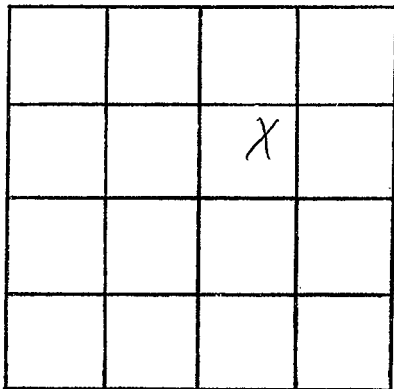

SECTION 1

Please indicate well location X.

ADDITIONAL INFORMATION

If more than one screen,
show locations of each on sketch.