




If well telescopes please sketch and show depths.

GROUND LEVEL

4" PVC  
TO 270

2" PVC  
TO  
453 FT.

20 FT  
2" PVC  
SCREEN

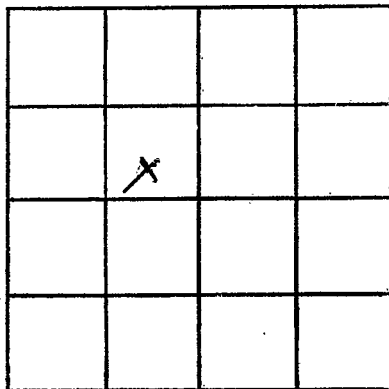

SECTION 15

Please indicate well location X.

ADDITIONAL INFORMATION

If more than one screen,  
show locations of each on sketch.