

Neshoba
 G 2001
 8/18/81

MISSISSIPPI
 BOARD OF WATER COMMISSIONERS
 416 North State Street
 Jackson, Mississippi 39201

WATER WELL DRILLERS LOG

8/18 1981 Beck Smith Neshoba
 date well completed firm name county well located

LANDOWNER:	description of formations encountered	from	to
Jack Weathersford	Top soil	0	14
Phila, MISS	White clay	14	28
(mailing address)	White sand	28	90
WELL LOCATION:			
sec. 2 T. 11 (N) R. 12 (E)			
5 miles NE of Phila			
(distance) (direction) (nearest town)			
WELL PURPOSE: BALL PARK			
(home, irrigation, municipal, industrial)			
WELL COMPLETION DATA:			
(1) diameter (inches) 2 1/2			
(2) total depth (feet) 90			
(3) static water level (feet) 40 below top of ground.			
(4) casing PVC 85 (material) (depth)			
(size) If telescope see back.			
(5) screen 5 1/2 85 (length) (depth to top)			
1 0/10 PVC (size) (material)			
(6) pump 1 10 (HP) (yield gpm)			
elec (type power)			
(7) electric log (yes or no)			
(organization running log)			
(8) how well bottom plugged PVC Plug			

DEPT. OF NATURAL RESOURCES
 BUREAU OF LAND & WATER RESOURCES


SEP - 8 1981

RECEIVED

DRILLERS REMARKS:

If well telescopes please sketch and show depths.


GROUND LEVEL

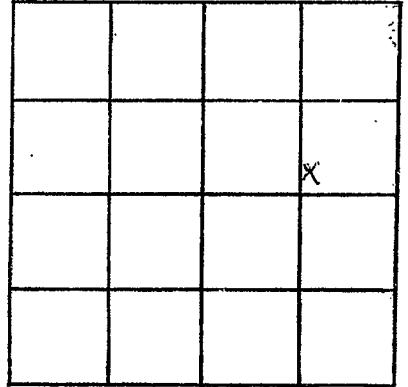

SECTION _____

Please indicate well location X.

ADDITIONAL INFORMATION

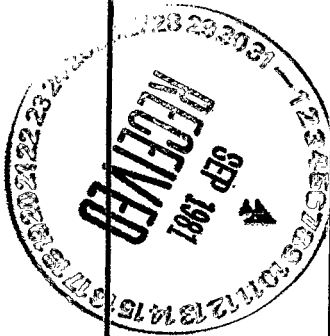

If more than one screen, show locations of each on sketch.