

MISSISSIPPI DEPARTMENT OF NATURAL RESOURCES
Bureau of Land and Water Resources
 Southport Mall
 P.O. Box 10631
 Jackson, Mississippi 39209
WATER WELL DRILLERS LOG

NESHOPA
G 2002

4-7 date well completed 19 86 firm name Smiths well Drilling neshoba county well located

LANDOWNER: PAT Green

description of formations encountered

from to

Red clay	0	10
Blue chalk	10	180
Blue Pepper Sand	180	225

(mailing address)

WELL LOCATION:

sec 31 T 11 N R 12 E
1 miles E of Phila
 (distance) (direction) (nearest town)

WELL PURPOSE: Irrigation
 (home, irrigation, municipal, industrial)

WELL COMPLETION DATA:

- (1) diameter (inches) 4"
- (2) total depth (feet) 225 FT
- (3) static water level (feet) 80 FT below above top of ground.
- (4) casing PVC, 170 FT
 (material) (depth)
 (size) if telescope see back.
- (5) screen 0,
 (length) (depth to top)
 (size) (material)
- (6) pump 1 HP, 20
 (HP) (yield gpm)
F
 (type power)
- (7) electric log no
 (yes or no)
 (organization running log)
- (8) how well bottom plugged open


DRILLERS REMARKS:

RECEIVED
APR 11 1996

Department of Natural Resources
 Bureau of Land & Water Resources

If well telescopes please sketch and show depths.

GROUND LEVEL

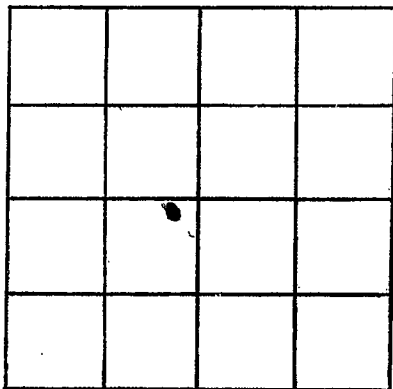

SECTION _____

Please indicate well location X.

ADDITIONAL INFORMATION

If more than one screen,
show locations of each on sketch.