

MISSISSIPPI DEPARTMENT OF NATURAL RESOURCES
Bureau of Land and Water Resources
 Southport Mall
 P.O. Box 10631
 Jackson, Mississippi 39209
WATER WELL DRILLERS LOG

Neshaba
G-2003

4-18 1986 Smith's well Drill neshaba
 date well completed firm name county well located

LANDOWNER: John Burt

description of formations encountered

from to

Red clay	0	15
Red Sand	15	22
Blue Clay	22	70
Blue Clay & Sand	70	120
Blue Clay	120	135
Sand	135	165

(mailing address)

WELL LOCATION:


sec. 2 T. 11 N. R. 12 E.
3 miles NE of Phila
 (distance) (direction) (nearest town)

WELL PURPOSE:

(home, irrigation, municipal, industrial)

WELL COMPLETION DATA:

- diameter (inches) 4
- total depth (feet) 165
- static water level (feet) 80 ^(below) above top of ground.
- casing PVC (155 depth)
 (size) if telescope see back.
- screen 10 (155 depth to top)
4 (PVC material)
 (size) (material)
- pump 1/2 (10 yield gpm)
E (type power)
- electric log (yes or no)
 (organization running log)
- how well bottom plugged CAP

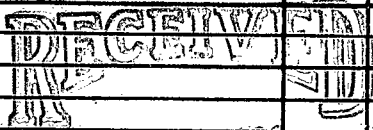


DRILLERS REMARKS:

Department of Natural Resources
 Bureau of Land & Water

If well telescopes please
sketch and show depths.

GROUND LEVEL

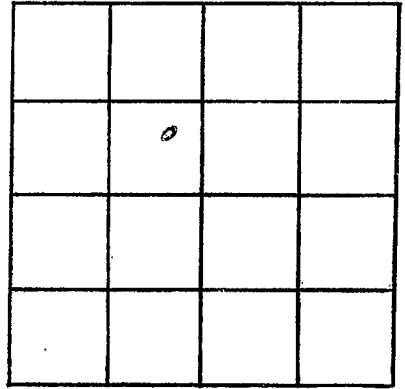

SECTION _____

Please indicate well location X.

ADDITIONAL INFORMATION

If more than one screen,
show locations of each on sketch.