

3 137

Neshoba
H 2
1-67
CODED

MISSISSIPPI
BOARD OF WATER COMMISSIONERS
416 North State Street
Jackson, Mississippi 39201
WATER WELL DRILLERS LOG

January 12 1967 Ogletree Drilling Neshoba
date well completed firm name county well located

LANDOWNER: Fred Dallas
Philadelphia, Miss.

description of formations encountered	from	to
	Red Clay	0
White Sand	20	60
Blue Chalk	60	150
Gray Sand	150	195

(mailing address)


WELL LOCATION:
sec 11 T 11 N R 13 E
S W
8 miles South of Phila.
(distance) (direction) (nearest town)

WELL PURPOSE: Home Use
(home, irrigation, municipal, industrial)

WELL COMPLETION DATA:

- (1) diameter (inches) 2 1/2
- (2) total depth (feet) 195
- (3) static water level (feet) 40 below top of ground.
- (4) casing Gav. 84
(material) (depth)
(size) if telescope see back.
- (5) screen None
(length) (depth to top)
(size) (material)
- (6) pump 1/2 5
(HP) (yield gpm)
(type power)
- (7) electric log (yes or no)
(organization running log)
- (8) how well bottom plugged


CODED

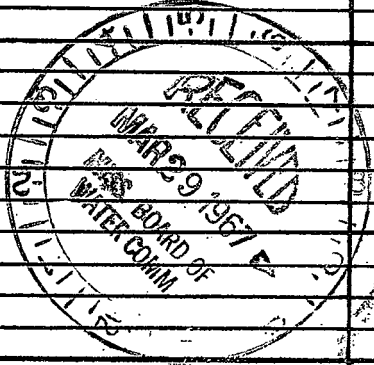

DRILLERS REMARKS:

If well telescopes please sketch and show depths.

GROUND LEVEL

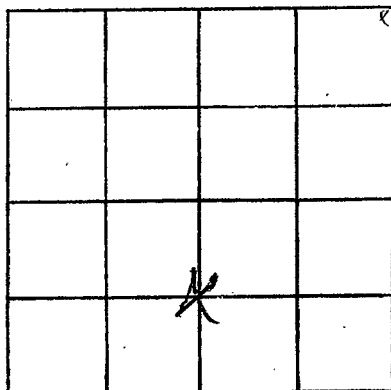

SECTION 11

Please indicate well location X.

ADDITIONAL INFORMATION

If more than one screen,
show locations of each on sketch.