

3.13T

Neshoba  
H3  
3-67

DEDED

MISSISSIPPI  
BOARD OF WATER COMMISSIONERS  
416 North State Street  
Jackson, Mississippi 39201

WATER WELL DRILLERS LOG

March 31 19 67 Ogletree Drilling Neshoba  
date well completed firm name county well located

LANDOWNER: Guy Gray

description of fomations encountered

from to

Philadelphia, Miss.

Red Clay

0 18

RT. 2

(mailing address)

Blue Chalk

18 98

Gray Sand

98 147

WELL LOCATION:

sec. 1 T. 11 N. R. 13 E.  
S W  
10 miles N.E. of Philaa.  
(distance) (direction) (nearest town)

WELL PURPOSE:  
(home, irrigation, municipal, industrial)

WELL COMPLETION DATA:

(1) diameter (inches) 2 1/2

(2) total depth (feet) 147

(3) static water level (feet) 40 below above top of ground.

(4) casing Galv. 84  
(material) (depth)

(size) if telescope see back.

(5) screen None  
(length) (depth to top)

(size) (material)

(6) pump 3/4 5  
(HP) (yield gpm)

(type power)


(7) electric log \_\_\_\_\_  
(yes or no)

(organization running log)

(8) how well bottom plugged \_\_\_\_\_


DRILLERS REMARKS:

CODER

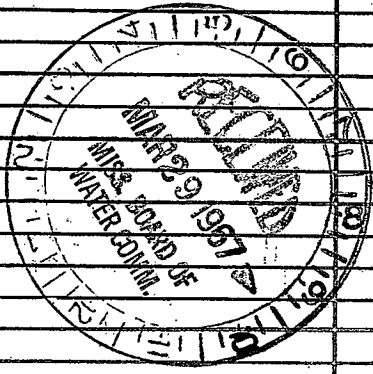

If well telescopes please sketch and show depths.

GROUND LEVEL

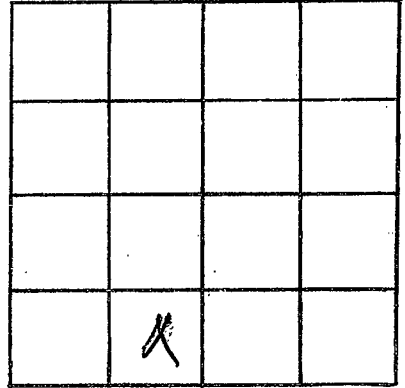

SECTION 1

Please indicate well location X.

ADDITIONAL INFORMATION

If more than one screen,  
show locations of each on sketch.