

CODED 3 13T

MISSISSIPPI
BOARD OF WATER COMMISSIONERS
416 North State Street
Jackson, Mississippi 39201

WATER WELL DRILLERS LOG

Neshoba
H5
8-67

AUGUST 28 1967 OGLETREE DRILLING NESHOPA
date well completed firm name county well located

LANDOWNER: WILLIWOODS

description of formations encountered

from to

RT. 2

RED CLAY

0 30

PHILADELPHIA, MISS.
(mailing address)

BLUE SAND

30 390

WHITE SAND

390 420

WELL LOCATION:

sec. 9 T. 11N R. 13 E
S W
7 miles N.E. of PHILA.
(distance) (direction) (nearest town)

WELL PURPOSE: HOME
(home, irrigation, municipal, industrial)

WELL COMPLETION DATA:

(1) diameter (inches) 4"
(2) total depth (feet) 420
(3) static water level (feet) 111 (below above top of ground.)

(4) casing PLASTIC 207,
(material) (depth)
if telescope see back.
(size)

(5) screen 10' 410
(length) (depth to top)
2" STAINLESS STEEL
(size) (material)

(6) pump 3/4 15
(HP) (yield gpm)


REA
(type power)

(7) electric log no
(yes or no)

(organization running log)

(8) how well bottom plugged POINTED

DRILLERS REMARKS:

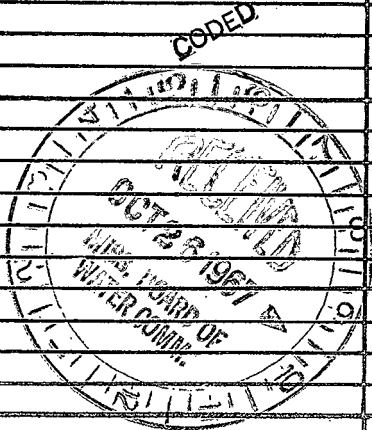

If well telescopes please sketch and show depths.

GROUND LEVEL


4"

↑
207

2"

↑ 217

Screen ↑ 10 ft.

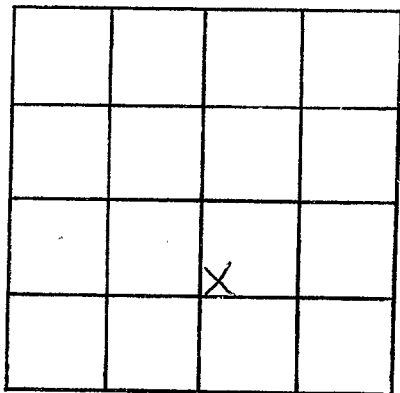

SECTION 9

Please indicate well location X.

ADDITIONAL INFORMATION

If more than one screen, show locations of each on sketch.