

3 13T

Neshoba
H Co
9-67

CODED

MISSISSIPPI
BOARD OF WATER COMMISSIONERS
416 North State Street
Jackson, Mississippi 39201

WATER WELL DRILLERS LOG

9-14 19 67 OGLETREE DRILLING NESHOBA
date well completed firm name county well located

LANDOWNER: HENRY CANNON

description of formations encountered from to

RT. 2
PHILADELPHIA, MISS.
(mailing address)

RED CLAY 0 20
WHITE SAND 20 68

WELL LOCATION:
sec. 18 T 11 N S R 13 E W
4 miles N.E. of Phila.
(distance) (direction) (nearest town)

WELL PURPOSE: HOME
(home, irrigation, municipal, industrial)

WELL COMPLETION DATA:

(1) diameter (inches) 2"

(2) total depth (feet) 68

(3) static water level (feet) 50 below above top of ground.

(4) casing Galv. 63
(material) (depth)

if telescope see back.
(size)

(5) screen 5' 68-63
(length) (depth to top)

1 1/2 STAINLESS STEEL
(size) (material)

(6) pump 3/4 4.5
(HP) (yield gpm)

REA
(type power)


(7) electric log
(yes or no)

(organization running log)

(8) how well bottom plugged POINTED


DRILLERS REMARKS:

CODED

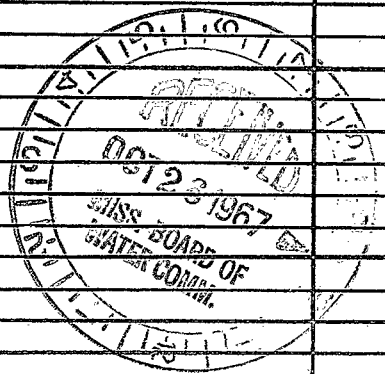

If well telescopes please sketch and show depths.

GROUND LEVEL

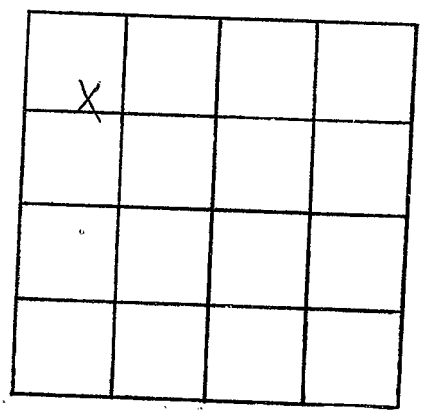

SECTION 18

Please indicate well location X.

ADDITIONAL INFORMATION

Lined area for additional information.

If more than one screen, show locations of each on sketch.