

5 134

Neshoba

H

3-68

CODED

MISSISSIPPI BOARD OF WATER COMMISSIONERS
416 North State Street
Jackson, Mississippi 39201

WATER WELL DRILLERS LOG

3-2-68 19
date well completed

R.R. Nicholson
firm name

Neshoba
county well located

LANDOWNER: W.C. Callaway

description of formations encountered

from to

Phila. Miss.
(mailing address)

Chalk + dirt
blue dirt
water sand

0 19'
19 118'
118 134'

WELL LOCATION:


sec. 32 T. 11 N. R. 13 E
9-8/10 miles east of Phila.
(distance) (direction) (nearest town)

WELL PURPOSE: home
(home, irrigation, municipal, industrial)

WELL COMPLETION DATA:

- (1) diameter (inches) 7"
- (2) total depth (feet) 134'
- (3) static water level (feet) 93' below above top of ground.
- (4) casing bas. 126'
(material) (depth)
2" if telescope see back.
(size)
- (5) screen 8' 134'
(length) (depth to top)
1/4" steel
(size) (material)
- (6) pump 1 7
(HP) (yield gpm)
Electric
(type power)
- (7) electric log no
(yes or no)
(organization running log)
- (8) how well bottom plugged _____


MAY 14 1968
MISS. BD. OF WATER COMME.
CODED

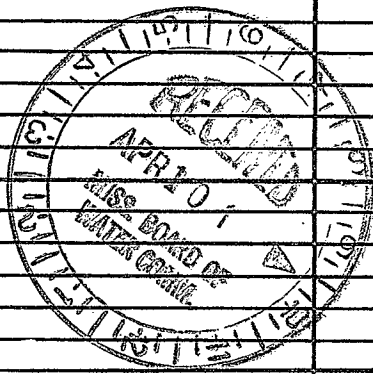

DRILLERS REMARKS: Good well

If well telescopes please
sketch and show depths.

GROUND LEVEL

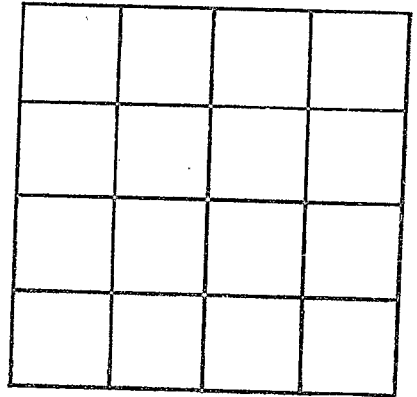

SECTION _____

Please indicate well location X.

ADDITIONAL INFORMATION

If more than one screen,
show locations of each on sketch.