

7301

WATER WELL DRILLERS LOG **CODED**

Date: 7-16, 1960, Driller: R. B. Nicholson, County: Washita
(Name)

Mississippi Forestry Commission

(1) Owner of Land: Sand Tower
(Name)
Phila., Miss
(Address)

(2) Location: $\frac{1}{4}$, $\frac{1}{4}$, Sec. 17 T¹¹ R¹³,
5 miles East, of Phila.
(distance) (direction) (Nearest Town)

(3) Topography: Hilly
(Hilly) (Flat) (Level)

(4) Purpose of Well: Domestic
(Domestic Irrigation
Municipal, Industrial, Other)

Description & Color of Materials Sand, Clay, Red Clay, Shell, etc.	Thickness Feet
Clay & Sand	1 50
Sand & Gravel	50 70
Blue dirt & fine sand	70 145
Coarse water sand	145 164

Information upon completion of well:

(1) Diameter $4\frac{1}{2}$ inches.

(2) Total Depth 164 feet.


(3) Water Level 115 feet below top of ground.

(4) Cased to 152, Size 2"

(5) Screen: Size 10, Length 10ft.

(6) Were any formations sealed against pollution?
 yes, no.

CODED

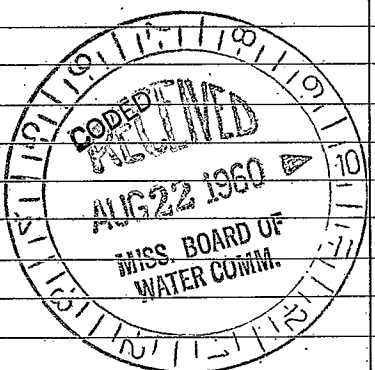

If YES depth of formation _____

Why _____

Drillers Remarks: Good drilling
Points in case
sand

(Use Back Side)

Well No.

