

H 9

6131

WATER WELL DRILLERS LOG

9-12-62 CODED

Date: 9-12, 1962, Driller: M. J. Ray, County: Neshoba

(Name)

(1) Owner of Land:	Description & Color of Materials Sand, Clay, Red Clay, Shell, etc.	Thick- ness Feet	Depth Feet
(Name) <u>McWilliams</u> (Address) <u>Philadelph. R#2</u> <u>9-11-13</u>	<u>Clay 10 ft</u> <u>Red Clay 10 ft</u> <u>Blue sandstone</u> <u>to 10 ft</u> <u>sand 180 ft</u>		
(2) Location: $\frac{1}{4}$, $\frac{1}{4}$ Sec. T. R. <u>9</u> miles <u>east</u> of <u>Phil</u> (distance) (direction) (Nearest Town)	<u>or 1/2 way</u> <u>to</u>		
(3) Topography: <input checked="" type="checkbox"/> (Hilly) <input type="checkbox"/> (Flat) <input type="checkbox"/> (Level)			
(4) Purpose of Well: <u>Domestic</u> (Domestic, Irrigation, Municipal, Industrial, Other)			


Information upon completion of well:

- (1) Diameter 2 inches.
- (2) Total Depth 200 feet.
- (3) Water Level 100 feet below top of ground.
- (4) Cased to 8 ft, Size 2 in
- (5) Screen: Size none Length: _____
- (6) Were any formations sealed against pollution?
 yes, no.

If YES depth of formation _____
Why _____

Drillers Remarks: Casing sealed
at 84 ft

CODED

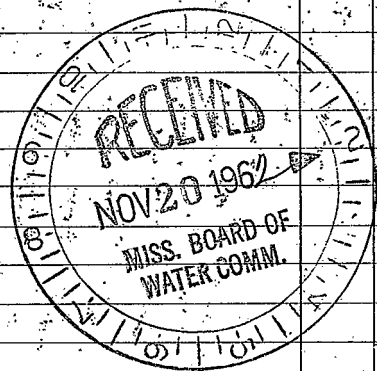

(Use Back Side)

Well No.

