

NESHOPA

6 137
WATER WELL DRILLERS LOG

H 12

9-25-62
Date: 9-29-62, 1962 Driller: M L Ray County Neshoba

(1) Owner of Land: Kirkland
 (Name) Herman Kirkland
 (Address) Phala #2
36 11 13
 (2) Location: 1/4, 3/4, Sec. T R
11 miles east of Phala
 (distance) (direction) (Nearest Town)
 (3) Topography: (Hilly) (Flat) (Level)
 (4) Purpose of Well: Domestic
 (Domestic Irrigation Municipal, Industrial, Other)


Description & Color of Materials Sand, Clay, Red Clay, Shell, etc.	Thick- ness Feet	Depth Feet
<u>Sand to 20 ft</u>		
<u>Mixed blue dirt</u>		
<u>& Sand to 110 ft</u>		
<u>plac clay 110 "</u>		
<u>Sand 110X130 "</u>		

Information upon completion of well:

(1) Diameter 2 inches.
 (2) Total Depth 130 feet.
 (3) Water Level 45 feet below top of ground.
 (4) Cased to 63 ft Size 2 in
 (5) Screen: Size none Length _____
 (6) Were any formations sealed against pollution?
 _____ yes, no.

CODED

If YES depth of formation _____
 Why _____
 Drillers Remarks: Casing sealed
at 36 ft in hard
blue

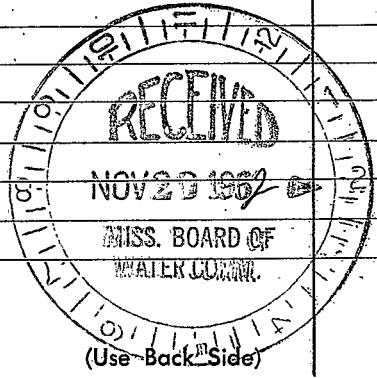

Well No.

