

CODED

MISSISSIPPI  
BOARD OF WATER COMMISSIONERS  
416 North State Street  
Jackson, Mississippi 39201

WATER WELL DRILLERS LOG

NEKHOBA  
H 14  
11-12-69

11-12 1969 Comans Drilling Neshoba  
date well completed firm name county well located  
Seneca

LANDOWNER: JUNIOR  
Stewart  
Philadelphia R 4 Miss  
(mailing address)

| description of formations encountered | from       | to         |
|---------------------------------------|------------|------------|
| <u>Clay</u>                           | <u>148</u> | <u>45</u>  |
| <u>Red SAND</u>                       | <u>45</u>  | <u>49</u>  |
| <u>ROCK</u>                           | <u>49</u>  | <u>57</u>  |
| <u>Shall + Clay</u>                   | <u>57</u>  | <u>58</u>  |
| <u>Clay Rock</u>                      | <u>58</u>  | <u>84</u>  |
| <u>Clay</u>                           | <u>84</u>  | <u>128</u> |
| <u>Clay + Sand</u>                    | <u>128</u> | <u>199</u> |
| <u>SAND</u>                           | <u>199</u> | <u>215</u> |

WELL LOCATION:  
sec. 19 T. 11 N R. 13 E  
S W  
9 miles N.E of Philadelphia  
(distance) (direction) (nearest town)

WELL PURPOSE: Home  
(home, irrigation, municipal, industrial)

WELL COMPLETION DATA:

- (1) diameter (inches) 2"
- (2) total depth (feet) 214
- (3) static water level (feet) 109 below above top of ground.
- (4) casing Steel, 205,  
(material) (depth)  
           if telescope see back.  
(size)
- (5) screen: 9, ROV  
(length) (depth to top)  
          , S/S  
(size) (material)
- (6) pump Rod 3/4 HP  
(HP) (yield gpm)  
Electric  
(type power)
- (7) electric log NO  
(yes or no)  
            
(organization running log)
- (8) how well bottom plugged None


FEB 16 1970

DRILLERS REMARKS:

MISS. BD. OF  
WATER COM.

If well telescopes please sketch and show depths.

GROUND LEVEL

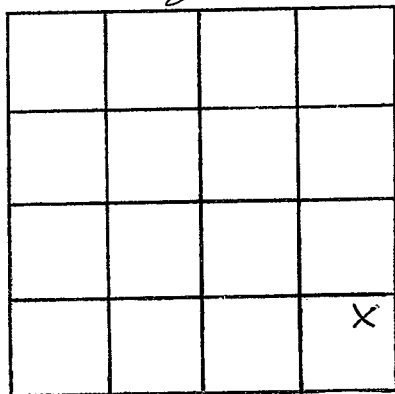

SECTION 19

Please indicate well location X.

ADDITIONAL INFORMATION

If more than one screen, show locations of each on sketch.