

WATER WELL DRILLERS LOG

H/6

9-28-63

Date: 12 8, 19 63 Driller: M Gray County: neho

(Name)

(1) Owner of Land: Ray Boston
(Name)
Phala mess R# 10
(Address)

(2) Location: 8 11 13
1/4, 1/4, Sec. T R
10 miles East of Phala
(distance) (direction) (Nearest Town)

(3) Topography: 2
(Hilly) (Flat) (Level)

(4) Purpose of Well: Domestic
(Domestic Irrigation
Municipal, Industrial, Other)

Description & Color of Materials Sand, Clay, Red Clay, Shell, etc.	Thick- ness Feet	Dept Fee
<u>Sand to 26 ft Gray</u>		
<u>Blue dirt to</u>		
<u>130 ft 20 ft</u>		
<u>of Blue sand</u>		

Information upon completion of well:

(1) Diameter 3 inches.

(2) Total Depth 147 feet.

(3) Water Level 60 feet below top of ground.

(4) Cased to 126, Size 3 in

(5) Screen: Size 2 in Length 6 ft


(6) Were any formations sealed against pollution?
 _____ yes, no.

If YES depth of formation _____

Why _____

Drillers Remarks: _____

CODED

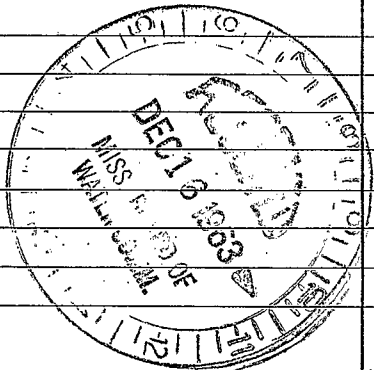

(Use Back Side)

Well No.

