

NESHOBA

H 18

9-10-70

MISSISSIPPI BOARD OF WATER COMMISSIONERS  
416 North State Street  
Jackson, Mississippi, 39201

WATER WELL DRILLERS LOG

**CODED**

9-10  
date well completed

1970 R.R. Wickham  
firm name

Neshoba  
county well located

LANDOWNER:

James L. Douglas  
Rt 2, Phila, Miss  
(mailing address)

description of formations encountered

from to

soil	15
clay	20
clay	45
clay	3
clay	11
clay	45
clay	25

WELL LOCATION:

sec. 1 T. 11 N R. 13 E  
15 miles East of Phila  
(distance) (direction) (nearest town)

WELL PURPOSE:

(home, irrigation, municipal, industrial)

WELL COMPLETION DATA:

- (1) diameter (inches) 4
- (2) total depth (feet) 240
- (3) static water level (feet) 185 below top of ground.
- (4) casing (material) 2" (depth) 10  
If telescope see back. (size)
- (5) screen 10" (length) 2'0" (depth to top)  
2" (size) 2" (material)
- (6) pump 1/2 (HP) 18 (yield gpm)  
P.E.A. (type power)
- (7) electric log (yes or no)
- (organization running log)
- (8) how well bottom plugged

**CODED**


DEC 15 1970

DRILLERS REMARKS:

MISS. BD. OF WATER COMM

If well telescopes please sketch and show depths.

*Nilley*  
GROUND LEVEL

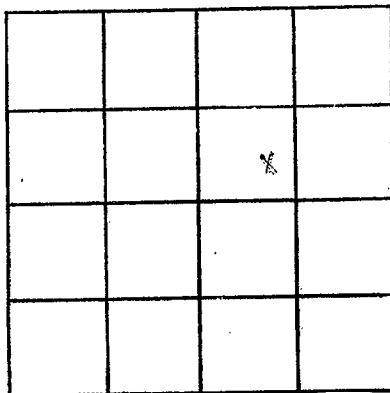

SECTION \_\_\_\_\_

Please indicate well location X.

ADDITIONAL INFORMATION

If more than one screen,  
show locations of each on sketch.